


NOTE: BEARINGS SHOWN ARE TRUE BEARINGS AND ARE BASED ON N.O.S. STATION "HERMISTON" USING A $\theta = 00^{\circ} 51' 25''$

LEGEND:
 ● DENOTES POINTS FOUND DURING THIS SURVEY
 ○ DENOTES 1/2" IRON PINS SET DURING THIS SURVEY
 () DENOTES RECORDED INFORMATION AS FILED WITH THE UMATILLA COUNTY SURVEYOR

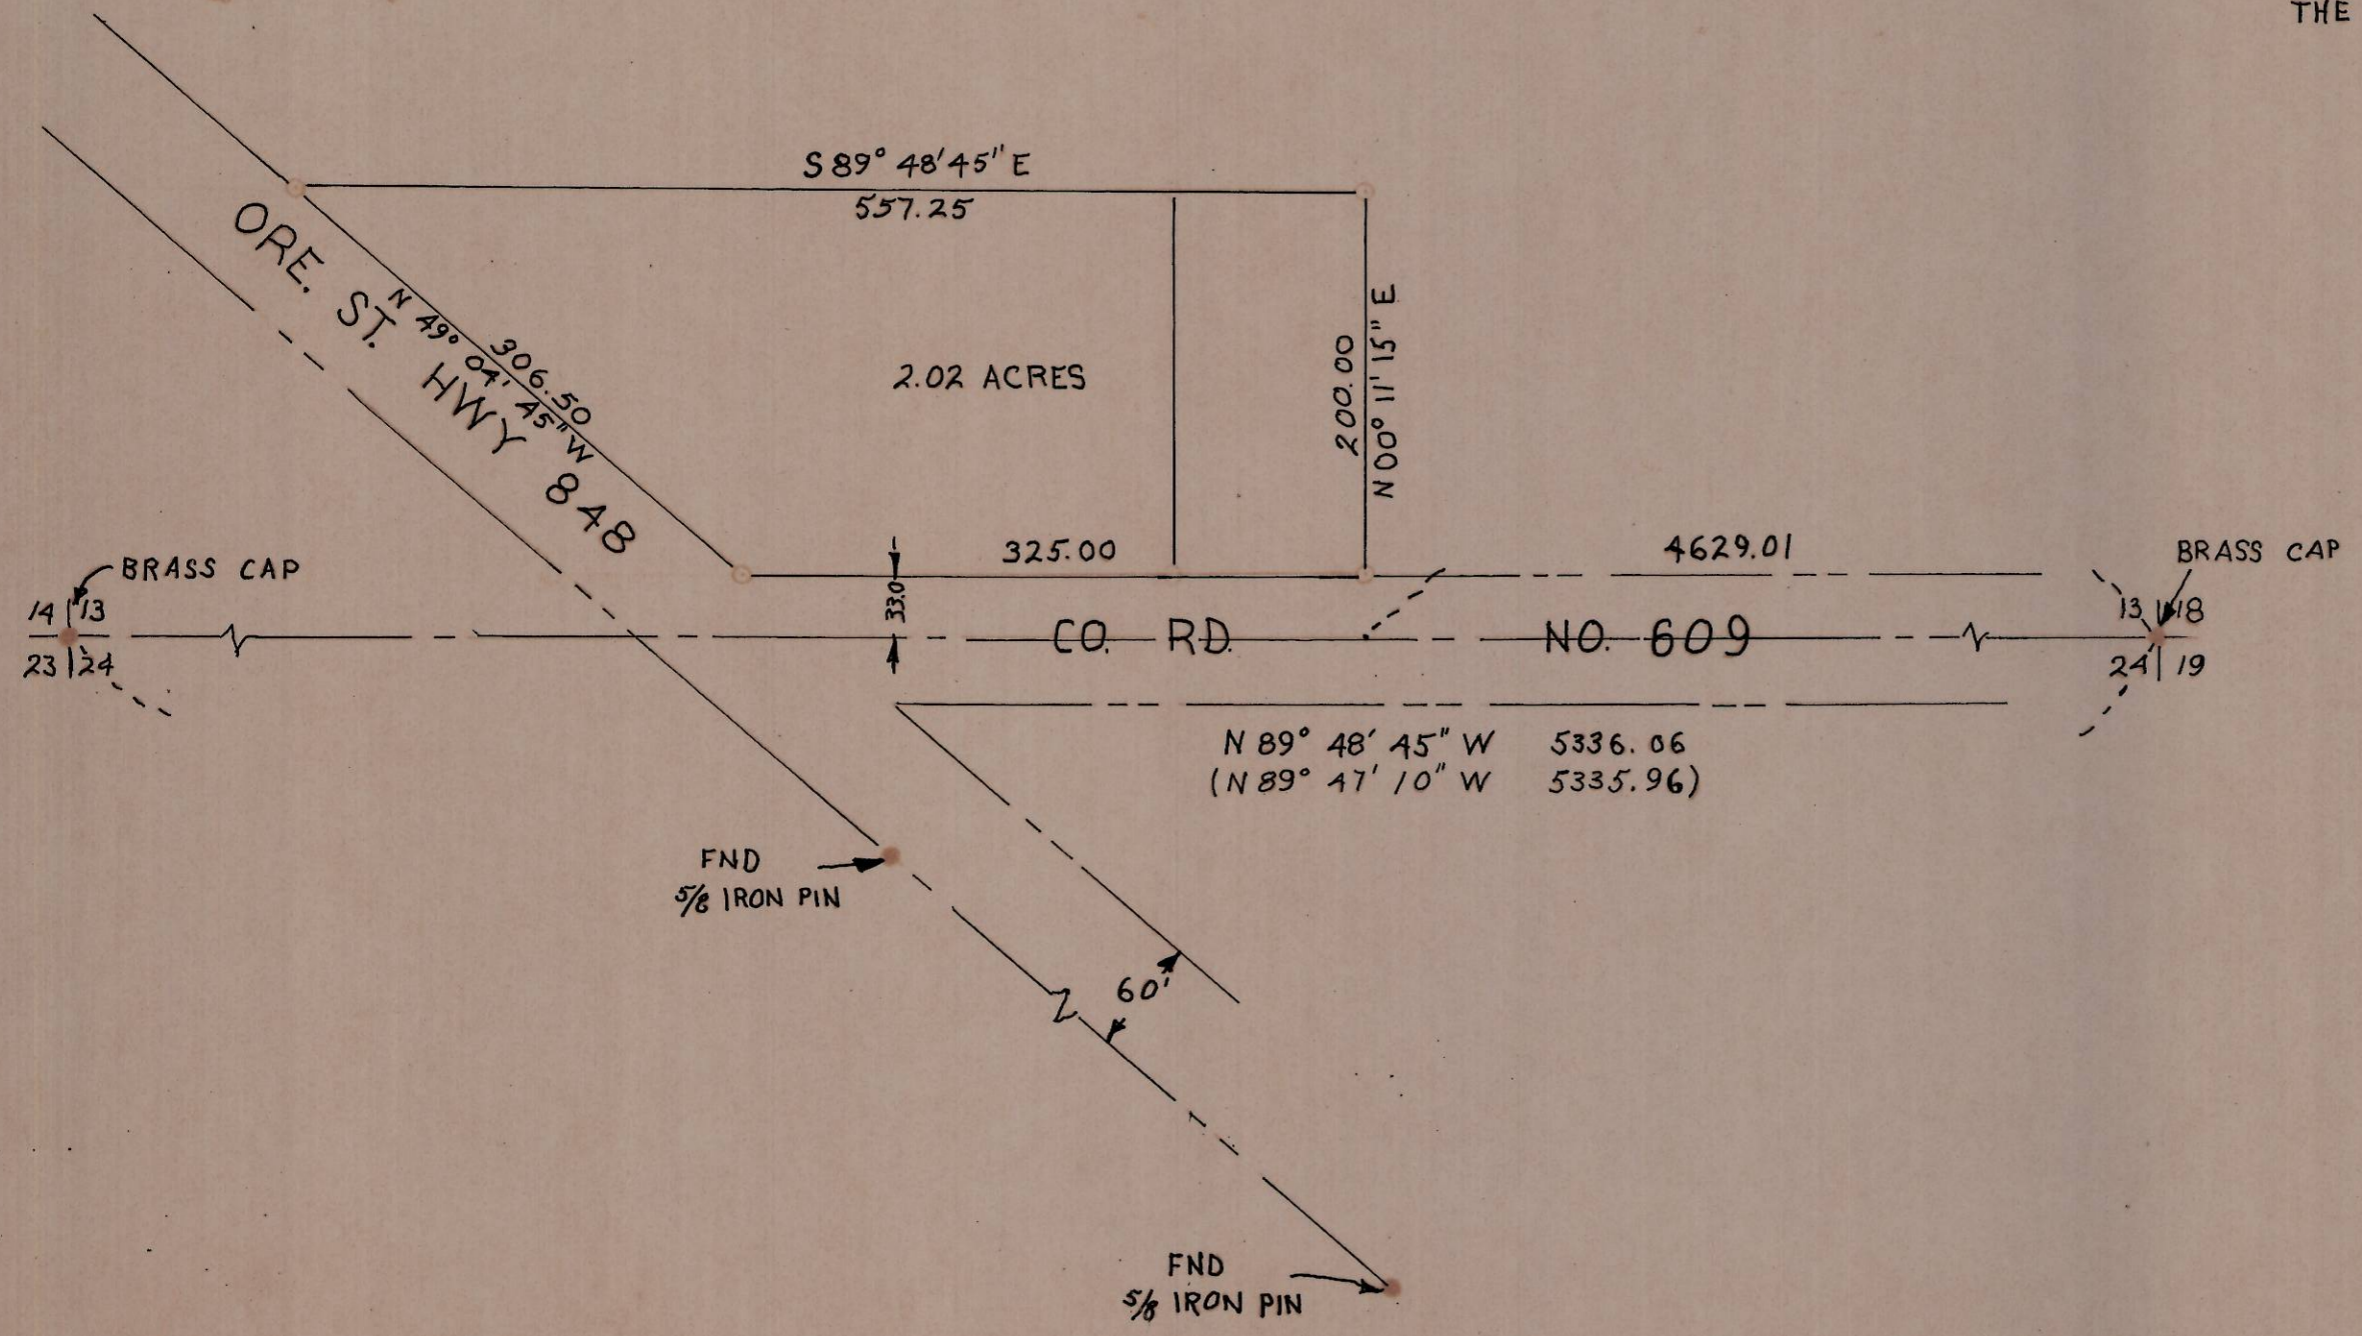

K-30-A

SURVEY IN SEC 13 T4N R28E
 FOR
 DR. STEFANIDES

WAYNE HARRIS CO. INC. K-30A
 ENGINEERS - SURVEYORS PENDLETON, ORE 97801
 SCALE DATE DRN BY CKD BY DRN. NO.
 1"=100' 2-16-76 EJA CTP 76-373A