

SURVEY FOR MIKE SCOTT

LOCATION SE 1/4, SE 1/4,  
SEC. 13, T 5 N, R 27 E, W.M., UMATILLA COUNTY, OREGON

DATE 5/6/76

SCALE 1" = 200'

● MONUMENTS FOUND

(000) OF RECORD


○ 1/2" IRON RODS SET

JOB NO. S 7604064

EDWARDS SURVEYING  
567-3336

P. O. Box 763  
Hermiston, Ore.

K-091-A

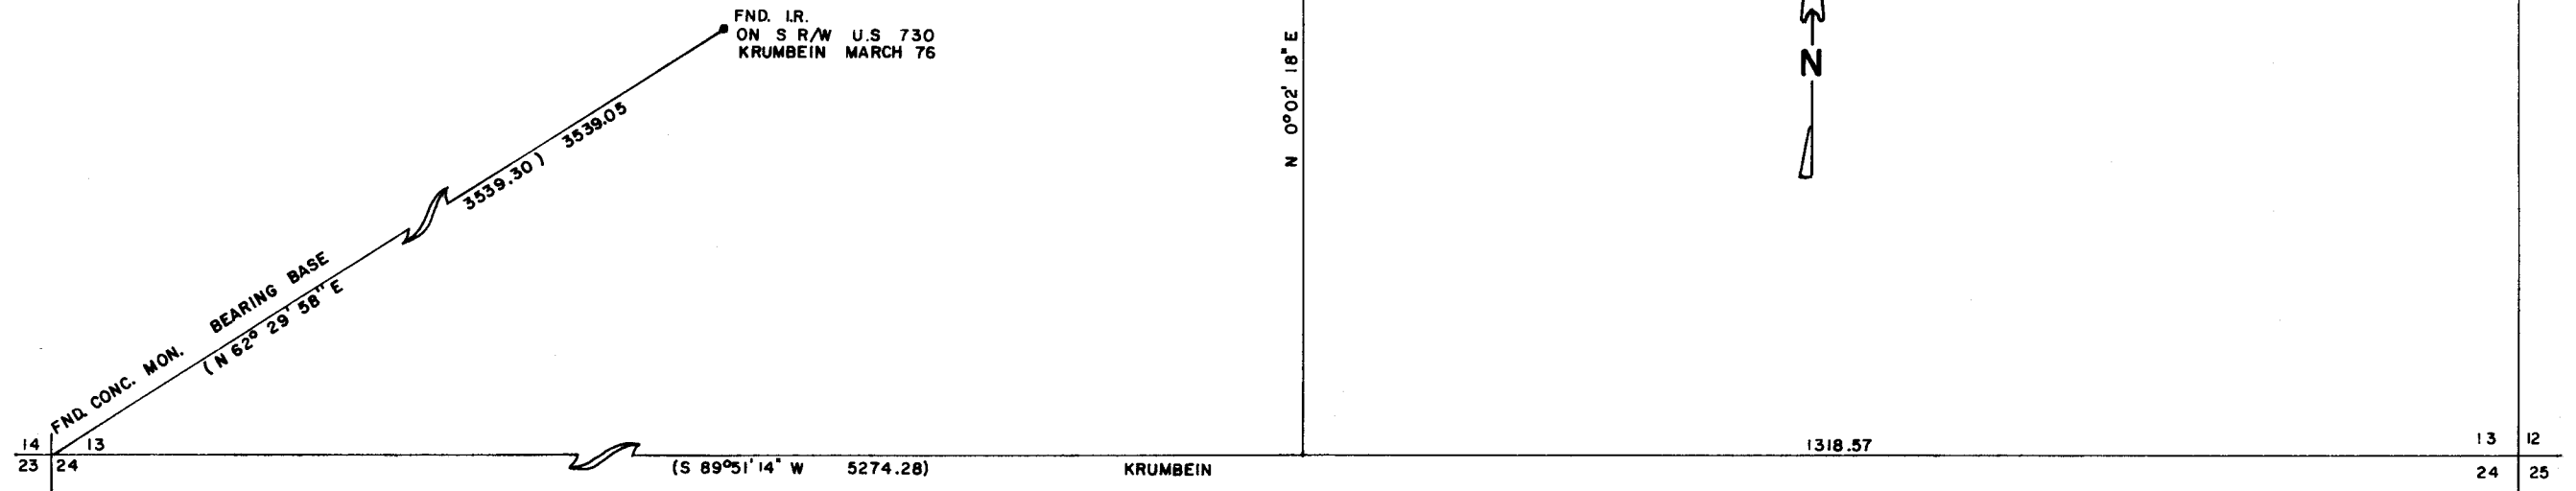

REGISTERED  
PROFESSIONAL  
LAND SURVEYOR

*G. Dennis Edwards*

OREGON  
JULY 16, 1971  
G. DENNIS EDWARDS  
951