


LEGEND:

- DENOTES PINS OR PIPES FND
- DENOTES 1/2" IRON PINS SET

NOTE: BEARINGS ARE TRUE BEARINGS AND ARE BASED ON UMATILLA COUNTY SURVEY RECORDS OF WORK DONE FOR McNARY ADDITION, UMATILLA, ORE. BY FRANK O. TALBOT

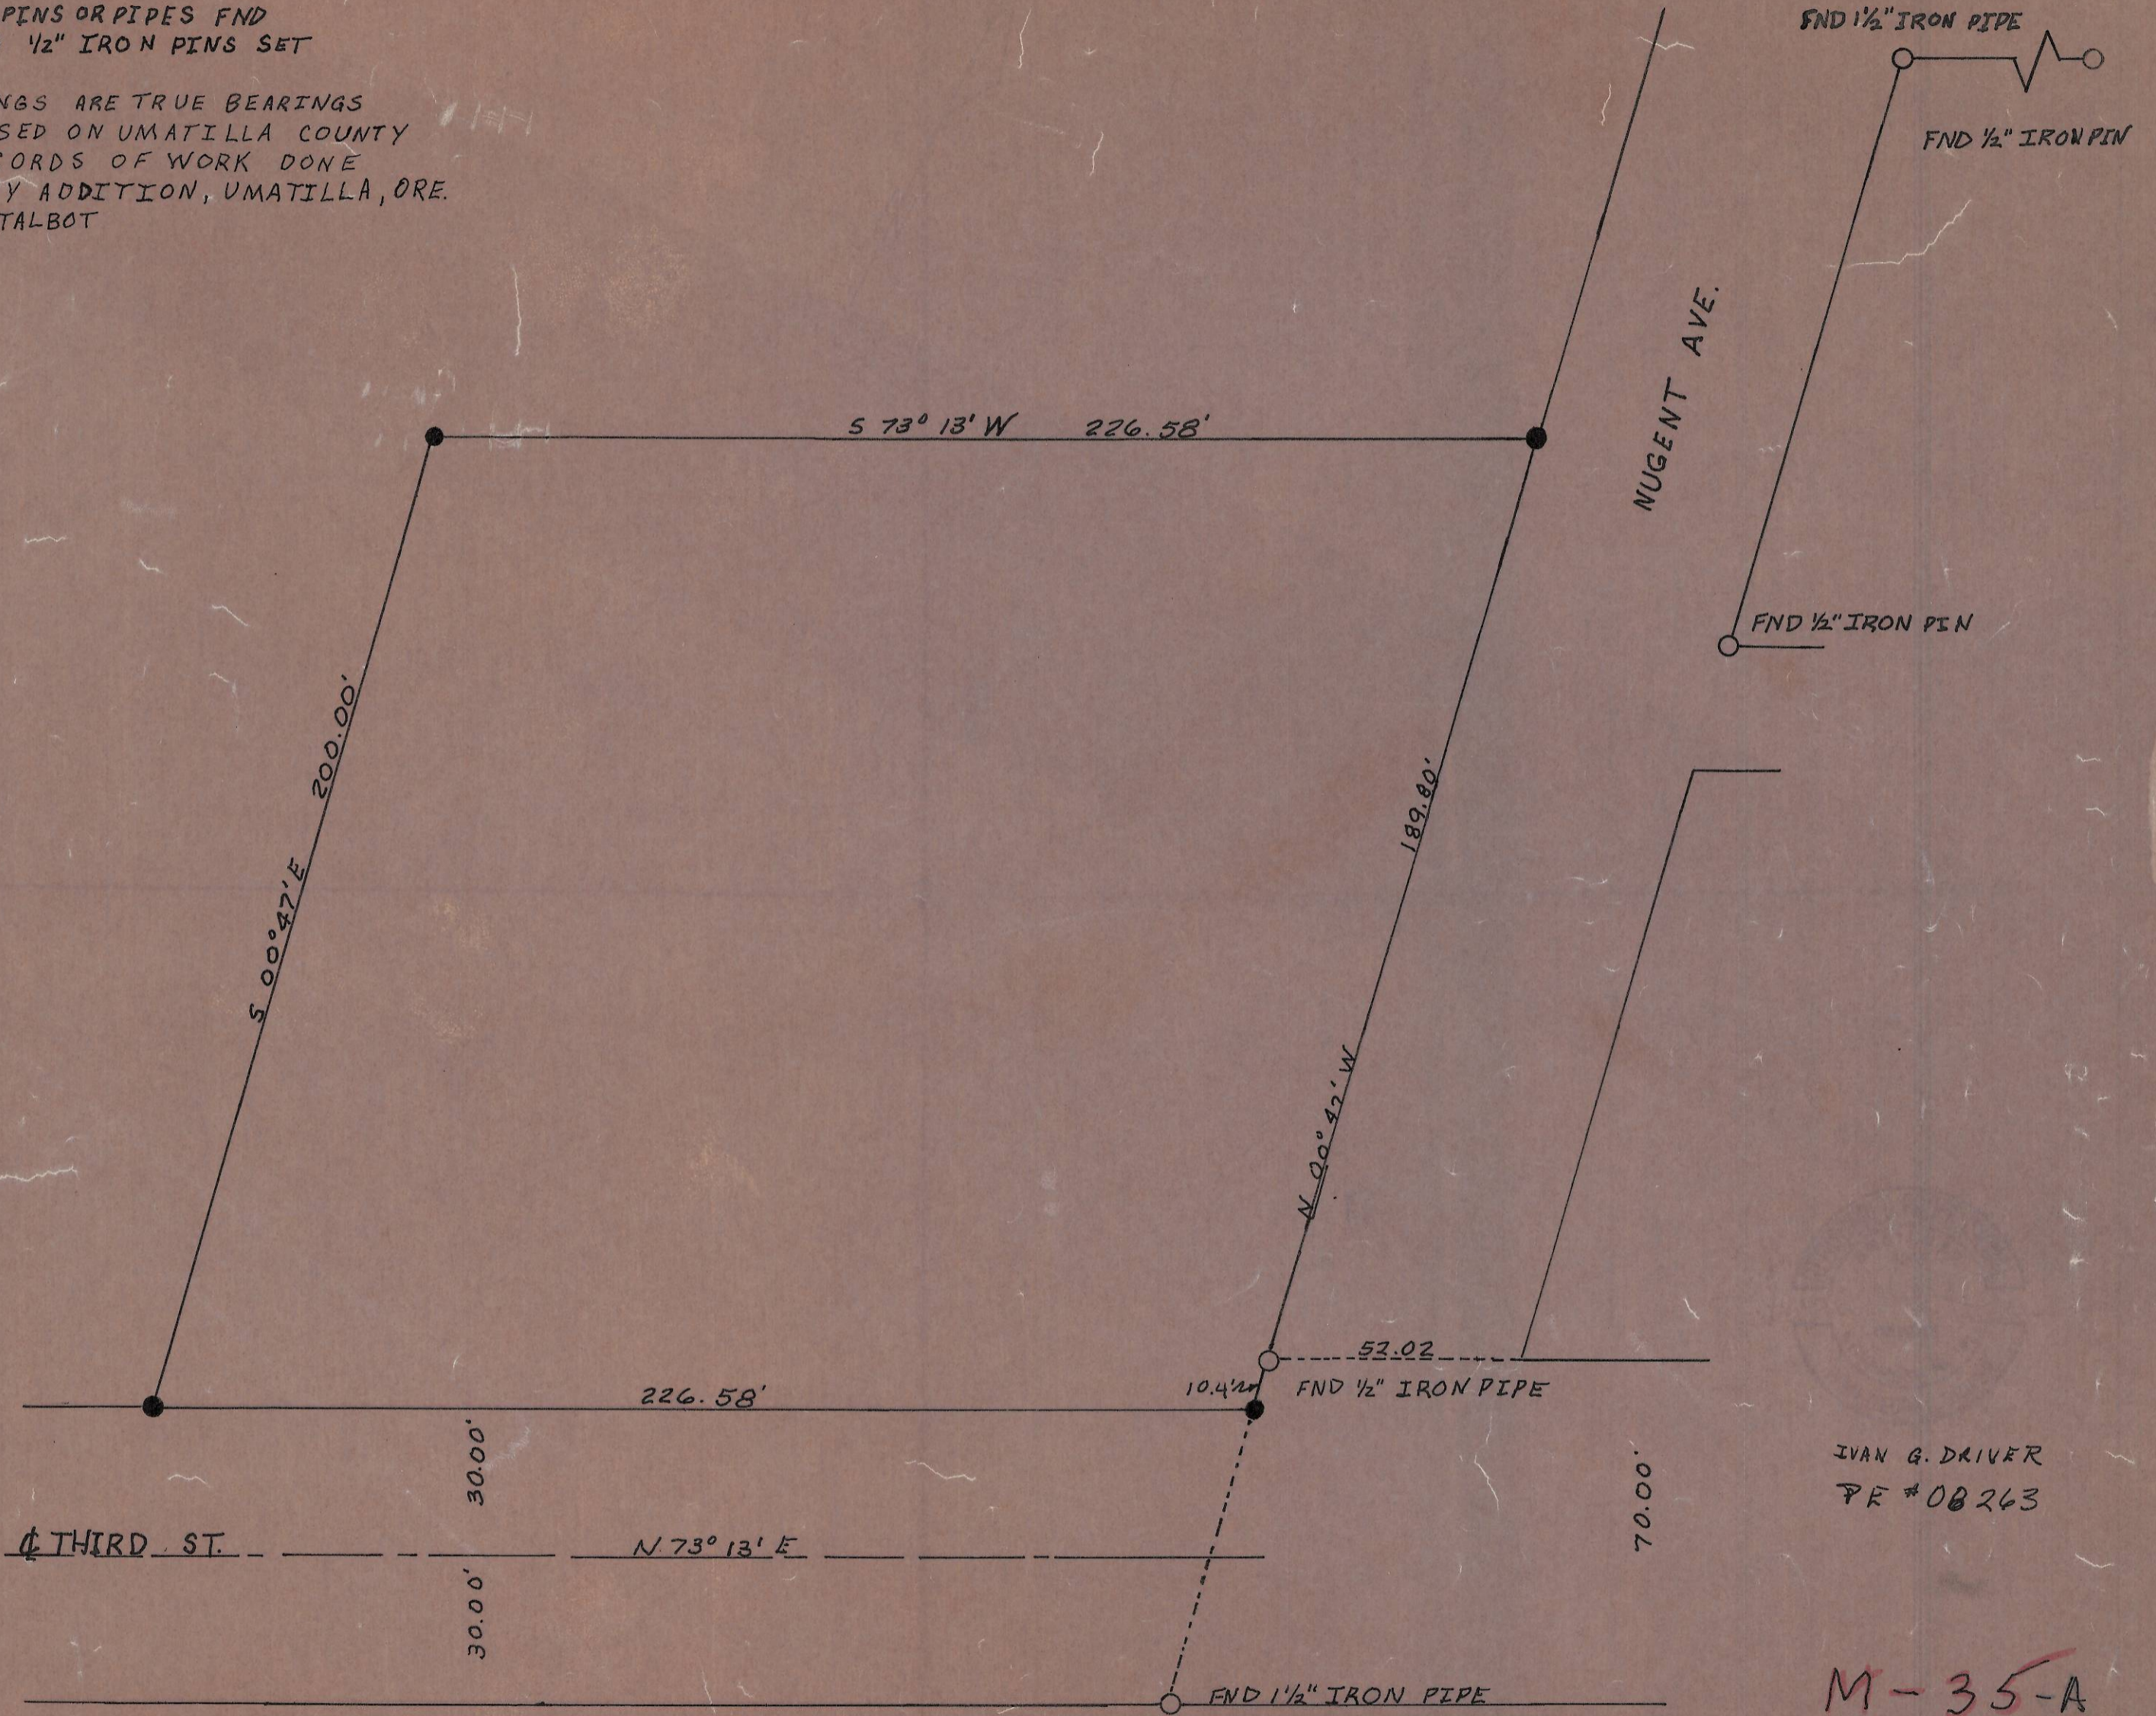

IVAN G. DRIVER
PE # 08263

M-35-A

SURVEY FOR H.R. CONSULTING SERVICES
SITUATED IN SECTION 17, Township 5 North,
Range 28 East, W.M., UMATILLA COUNTY,
OREGON

WAYNE HARRIS CO. INC.

SCALE 1" = 30'
DATE 10/6/76

DWG. NO.
76-398A

M-35-A

WAYNE HARRIS CO., INC.

Engineers and Surveyors Foresters Nurseries Landscape Construction

P. O. BOX 566 — S. E. 17TH & COURT PLACE
PENDLETON, OREGON 97801

TELEPHONE 276-7642

LEGAL DESCRIPTION FOR H.R. CONSULTING

Commencing at a point which is S. $77^{\circ}05'57''$ W., 2094.10 feet from the Northeast Section Corner of Section 17, Township 5 North, Range 28 East, Willamette Meridian and the true point of beginning for this description; thence N. $00^{\circ}47'$ W., 189.60 feet along the west right-of-way line of Nugent Avenue to a point; thence S. $73^{\circ}13'$ W., 226.58 feet to a point; thence S. $00^{\circ}47'$ E., 200.00 feet to a point on the north right-of-way line of Third Street; thence N. $73^{\circ}13'$ E., 226.58 feet along the north right-of-way line of Third Street to a point; thence N. $00^{\circ}47'$ W., 10.40 feet along the west right-of-way line of Nugent Avenue to the true point of beginning. Such described property to contain approximately 1.0 acre.

All being in McNary Addition to the City of Umatilla, Oregon, County of Umatilla, State of Oregon.

N-35-A