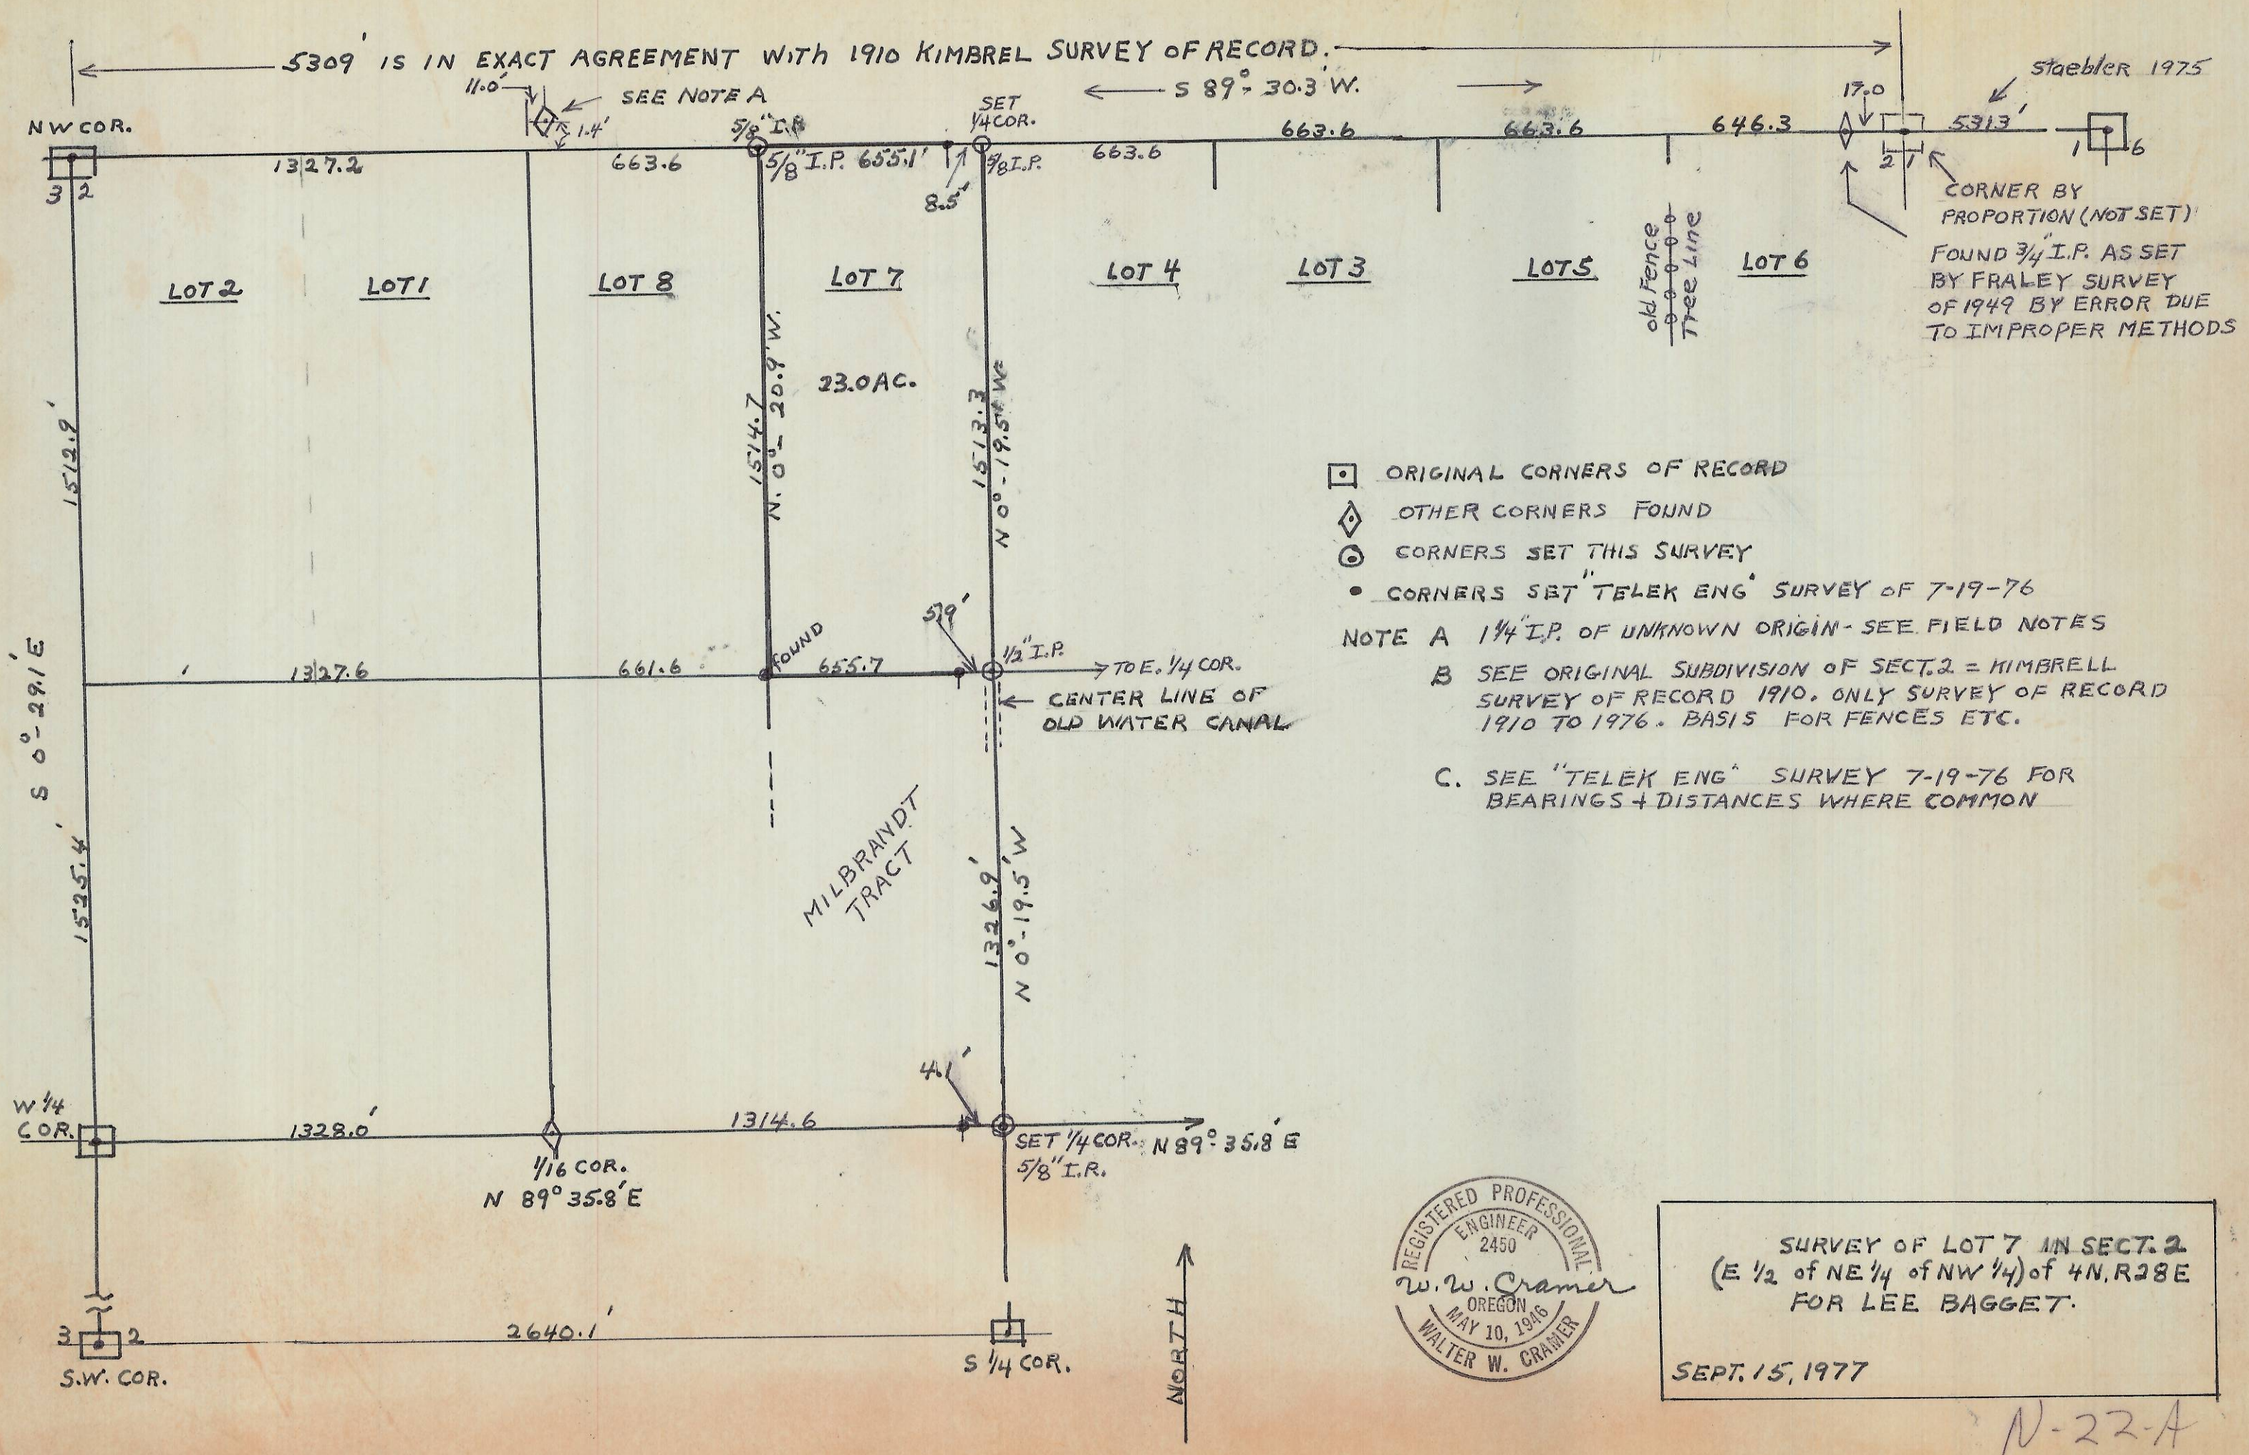

- ⊡ ORIGINAL CORNERS OF RECORD
- ◇ OTHER CORNERS FOUND
- ⊙ CORNERS SET THIS SURVEY
- • CORNERS SET "TELEK ENG" SURVEY OF 7-19-76

NOTE A 1/4" I.P. OF UNKNOWN ORIGIN - SEE FIELD NOTES

B SEE ORIGINAL SUBDIVISION OF SECT. 2 = KIMBRELL SURVEY OF RECORD 1910. ONLY SURVEY OF RECORD 1910 TO 1976. BASIS FOR FENCES ETC.

C. SEE "TELEK ENG" SURVEY 7-19-76 FOR BEARINGS + DISTANCES WHERE COMMON

REGISTERED PROFESSIONAL ENGINEER 2450
W. W. Cramer
OREGON MAY 10, 1946
WALTER W. CRAMER

SURVEY OF LOT 7 IN SECT. 2 (E 1/2 of NE 1/4 of NW 1/4) of 4N, R28E FOR LEE BAGGET.

SEPT. 15, 1977

N-22-A

N-22-A