


P-97-A

- ( ) DENOTES RECORD BEARING AND DISTANCE
- PINS FOUND
- 5/8" IRON ROD SET
- \*\*\* FENCE LINE
- DECLINATION - 20° 30' E

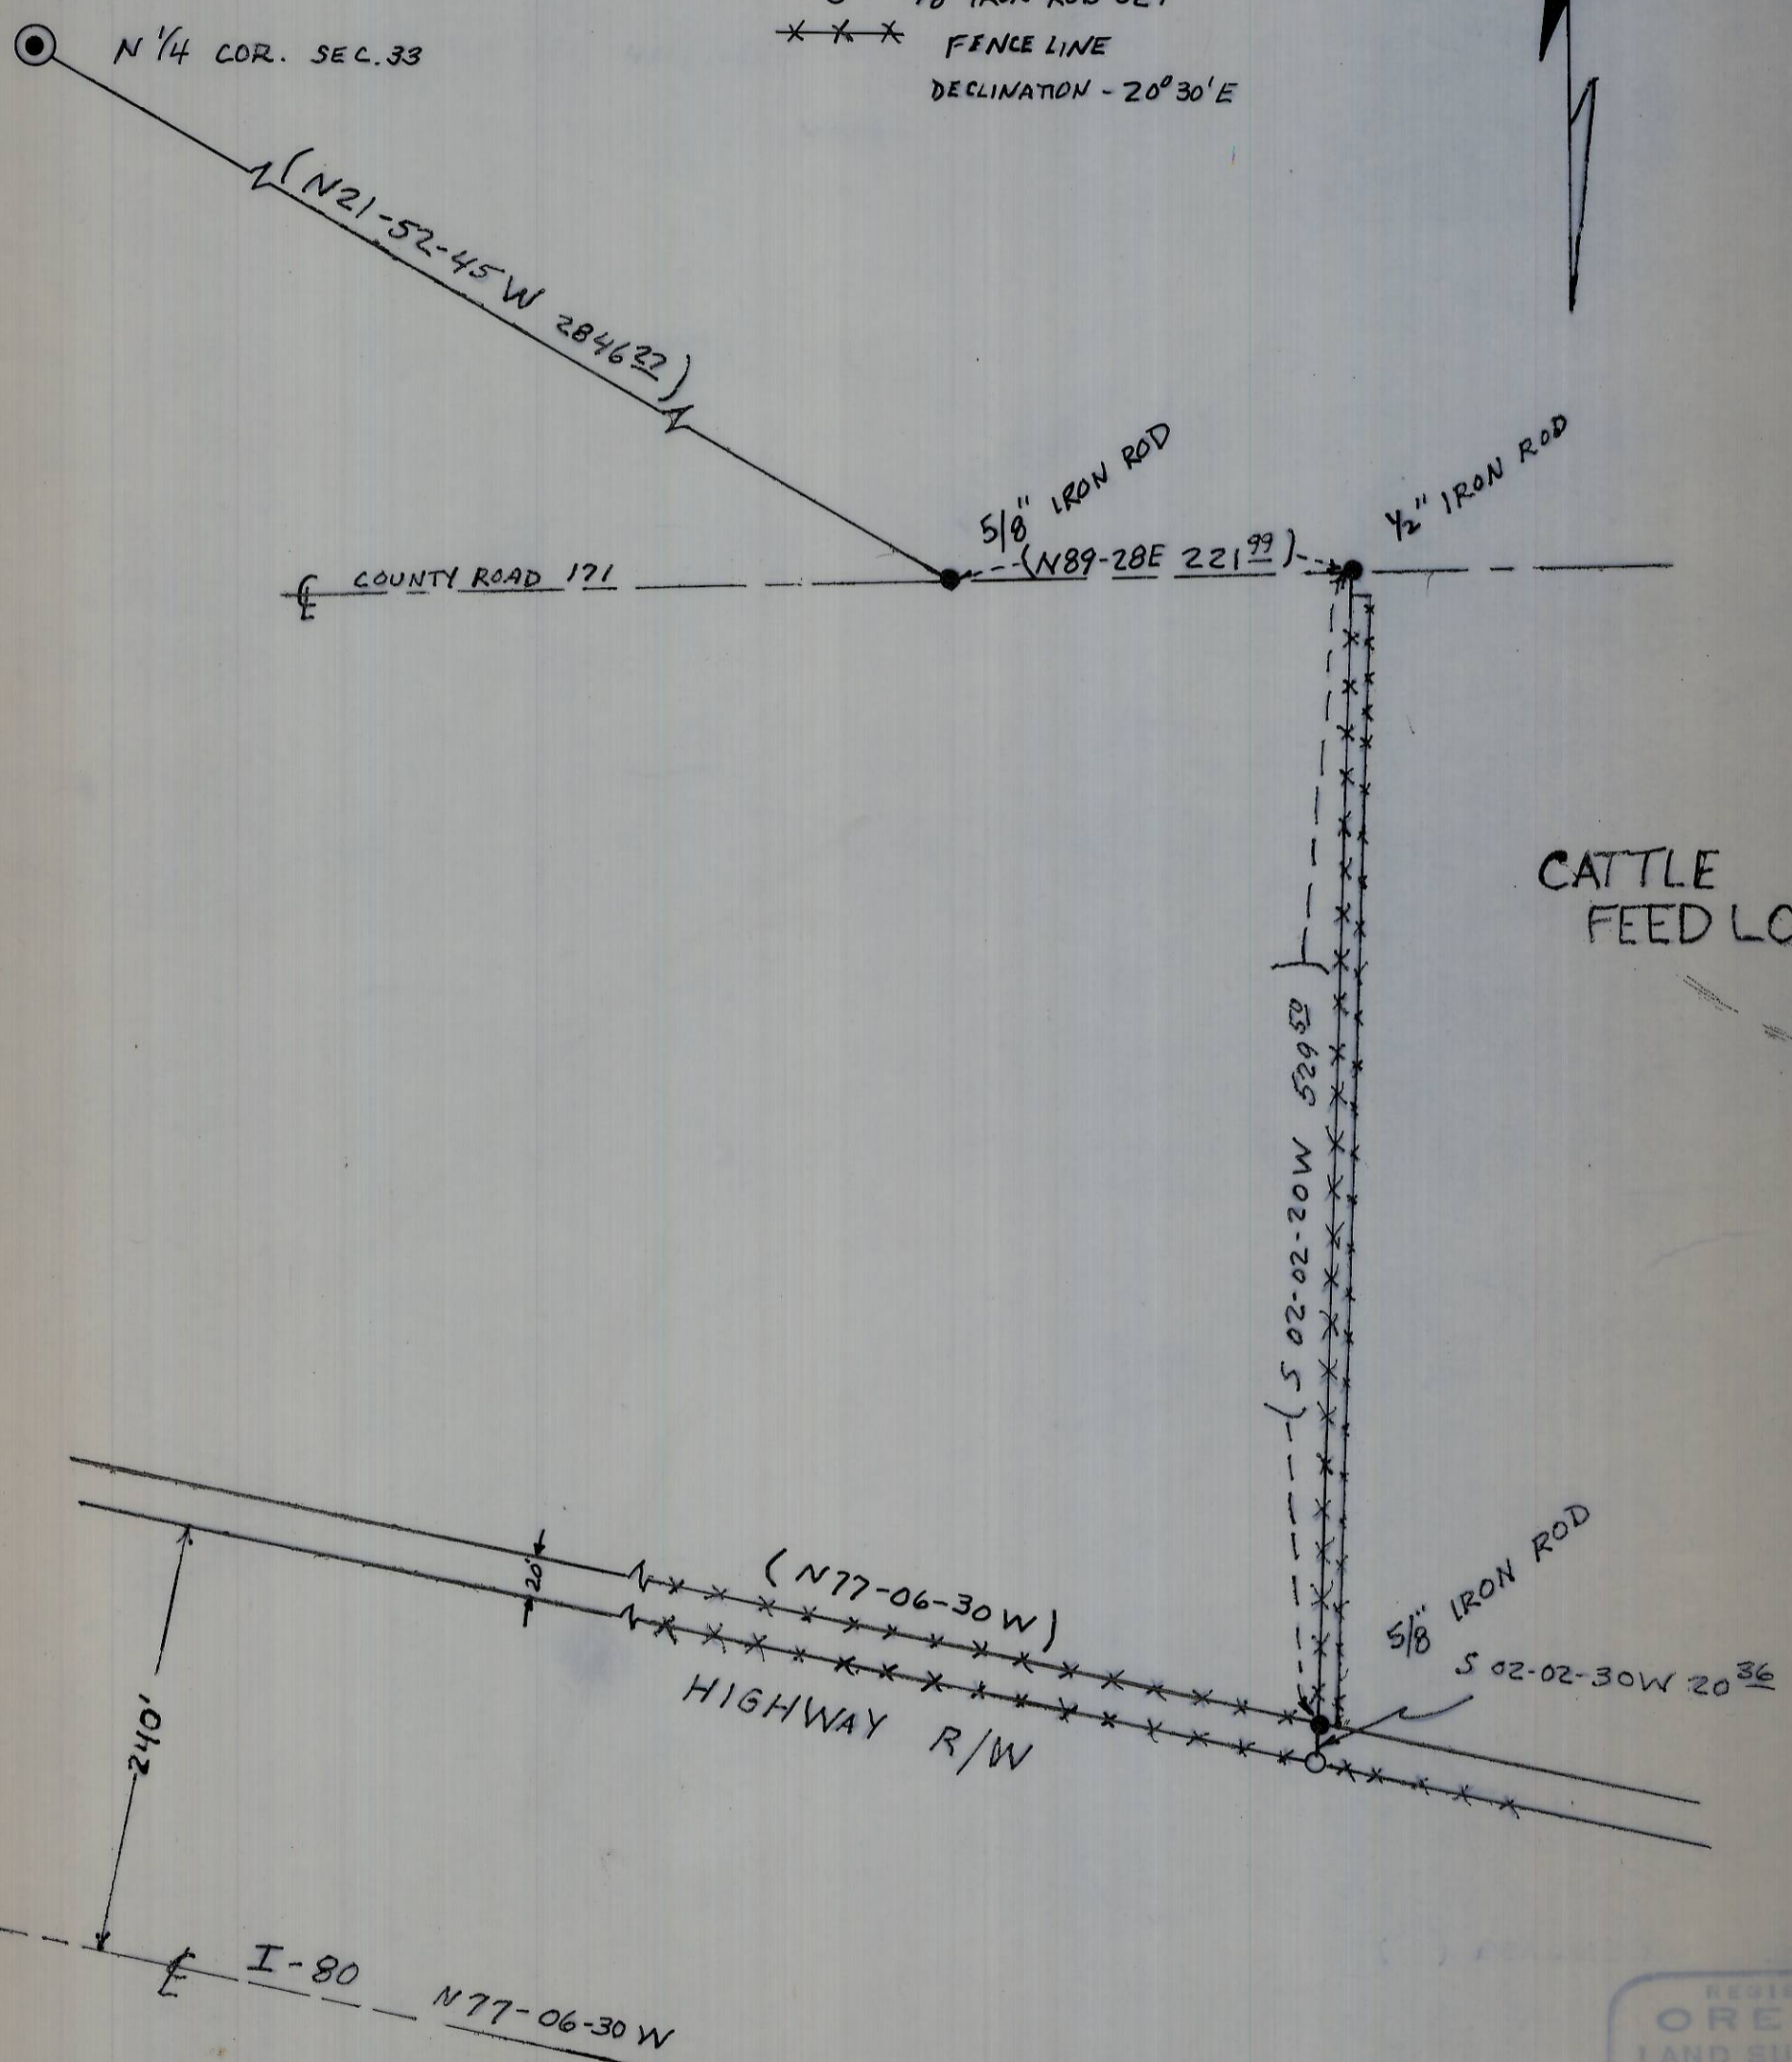

P-97-A

REGISTERED  
**OREGON**  
 LAND SURVEYOR  
*W O Harris*  
 MAY 9, 1955  
 WAYNE O. HARRIS  
 346

SURVEY FOR  
**PAT HOPPER**

SE 1/4, S33, T4N, R28E. W.M. **P-97-A**

WAYNE HARRIS CO. INC.				
ENGINEERS - SURVEYORS		PENDLETON, ORE		
SCALE	DATE	DWN	CHK	DWG. NO
1"=100'	10-18-78	MGM	ID	78-422A