

19 20  
30 29

20  
29

ROAD NO. 497  
W - 1308.6'


80 ACRES

S - 2662.8'

N - 2662.8'  
ROAD NO. 497

E - 1308.6'  
ROAD NO. 243

30 29

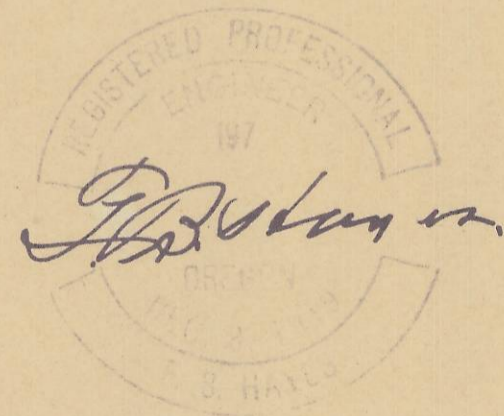

HAYES & HARRIS ENGINEERING

SURVEY FOR  
H.C. GERKING

SHOWING 80 ACRE TRACT IN NW 1/4, S. 29,  
T. 4 N., R. 34 E. W. M SOLD TO MRS. WOODARD

SCALE  
1" = 200'

DATE  
11-5-54

DRAWN BY  
W.O.H.

Q-705-A