


Center Sec. 3-
Stone $\frac{1}{4}$ + Md.

2660.4'

U.S. $\frac{1}{4}$ cor.
Stone $\frac{1}{4}$ + Md.
B.T's OK.

Map
Showing Tract of Land
Surveyed for
J. E. Smith Live Stock Co.
in
Sec. 3- T. 1 S.; R. 35 E. W. M.
July 1915.
Willard Bradley
County Surveyor.

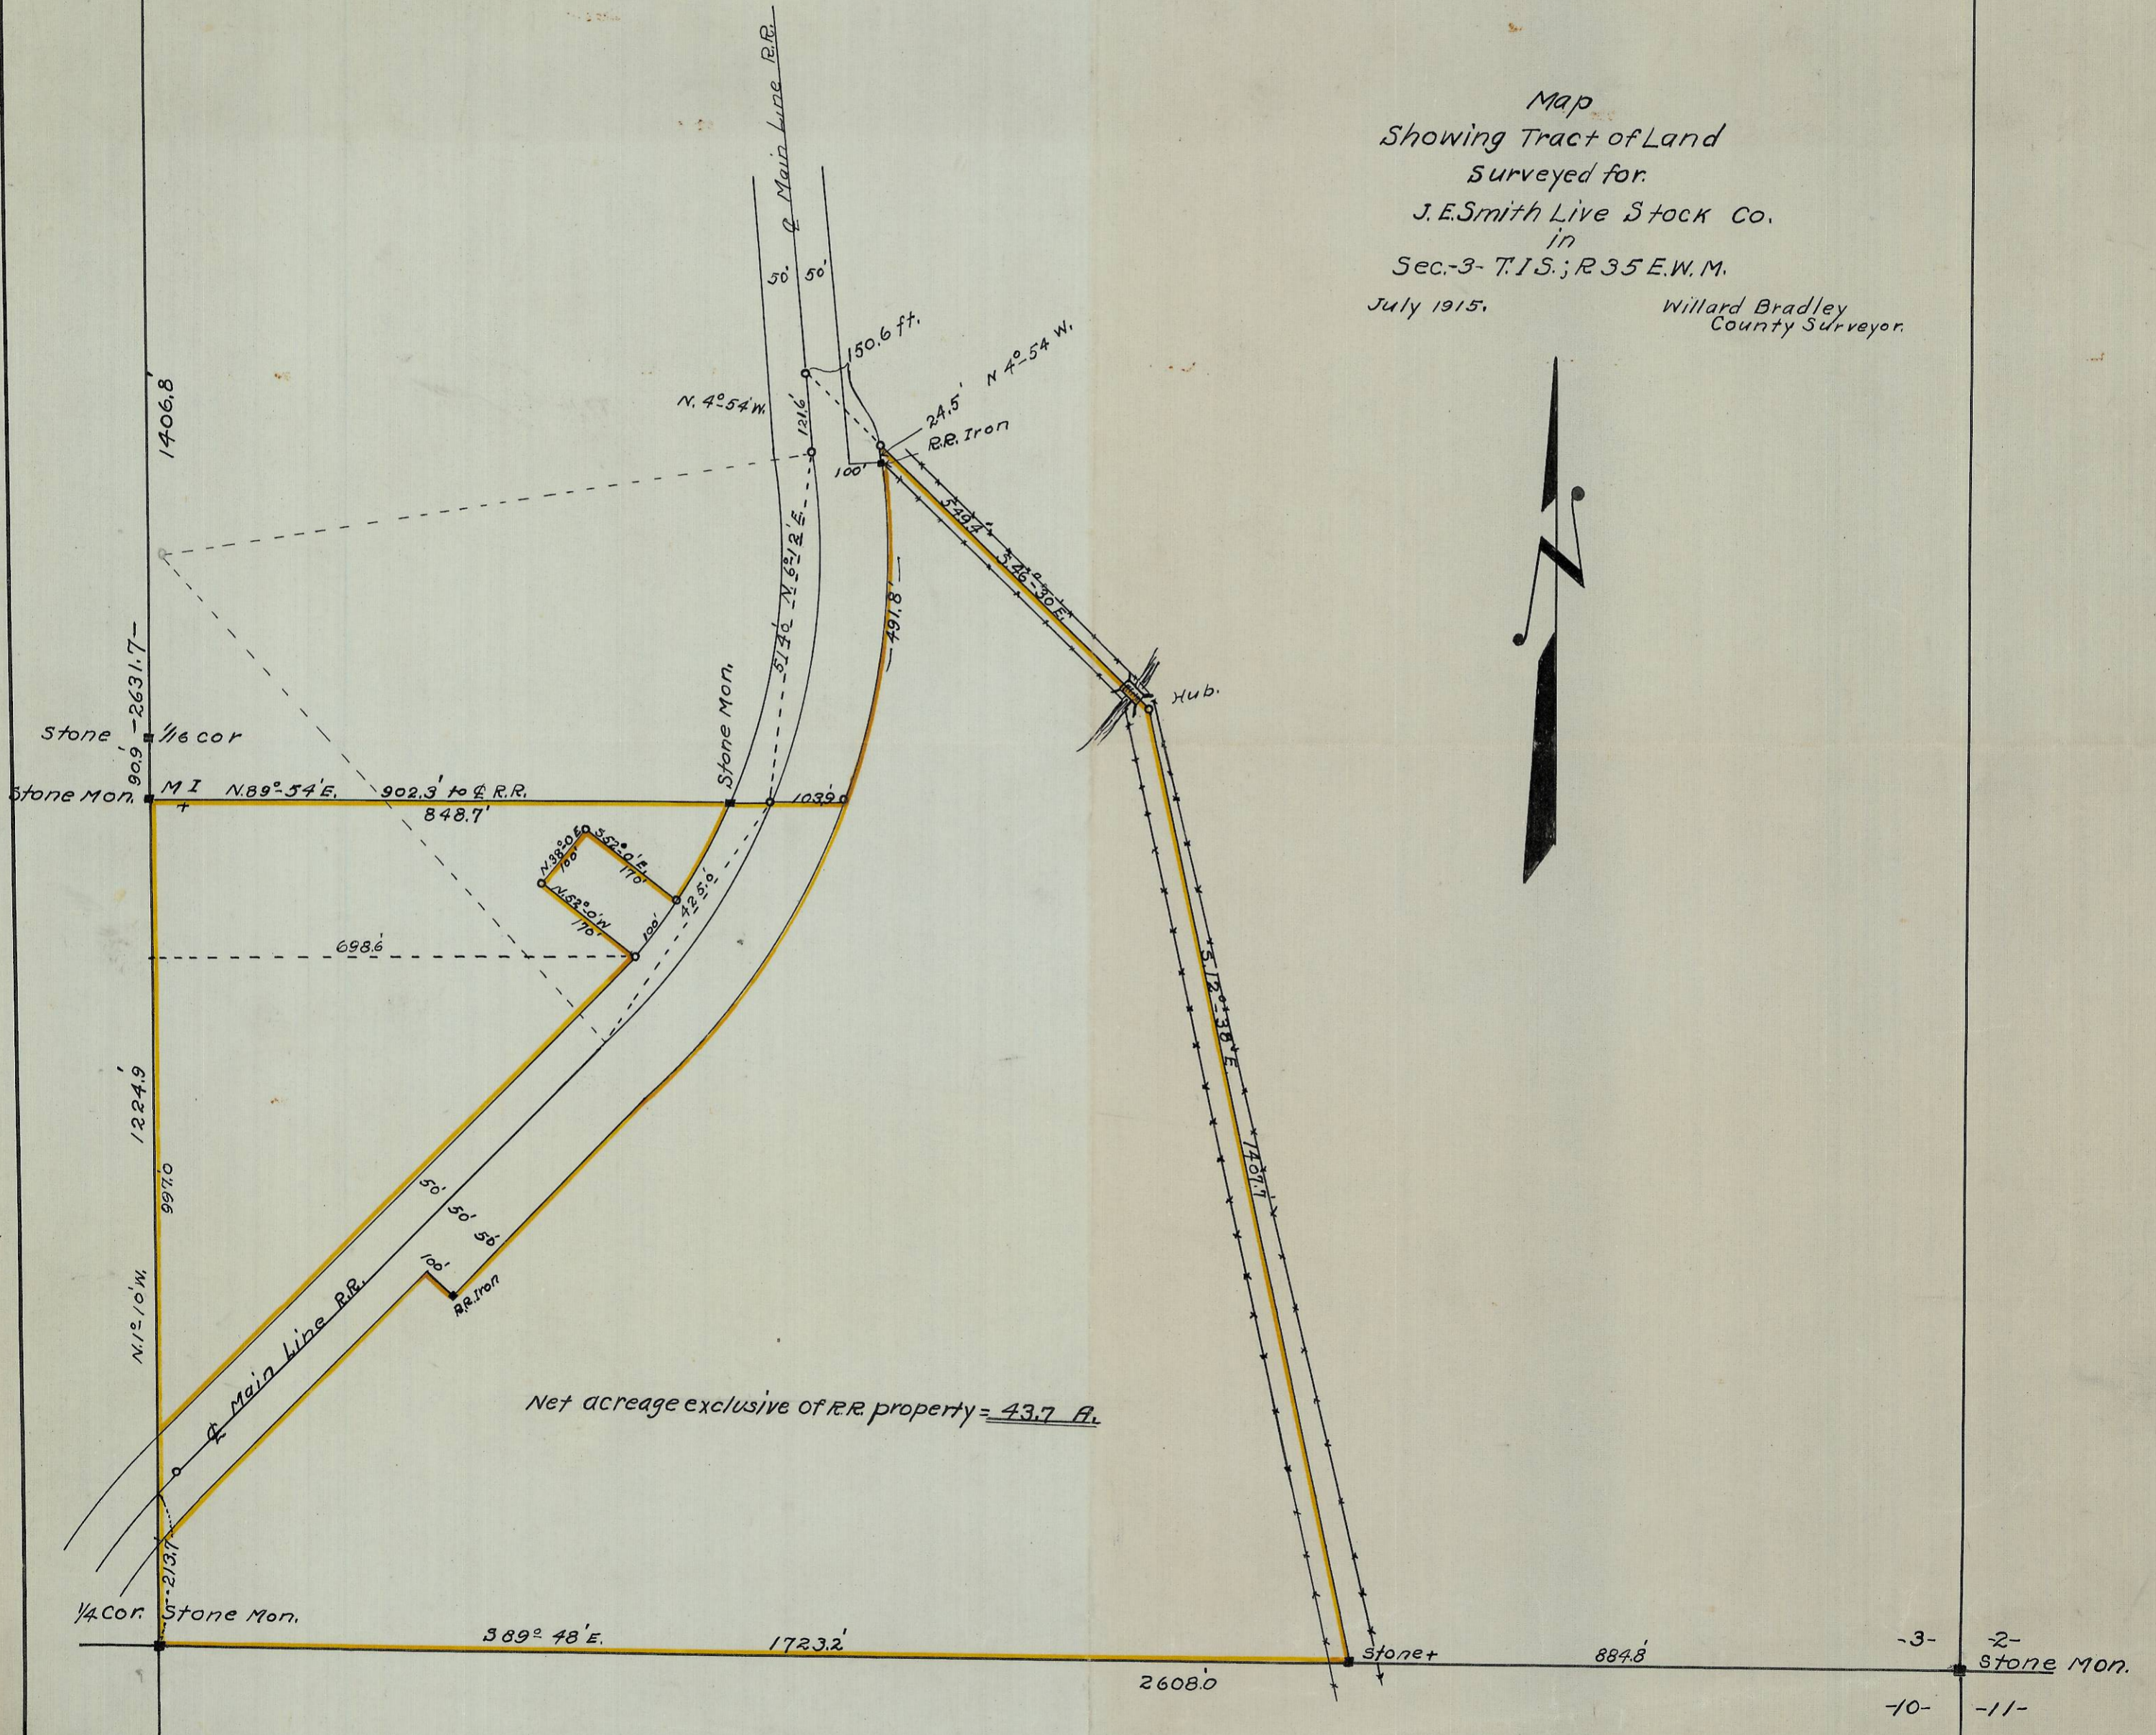

Q-879-A

18353 Q-879-A

1153