


FOUND 1" SQUARE ROD & BRASS CAP ON I. PIPE WITNESS CAPS 20.03' SE & 24.58' WEST.

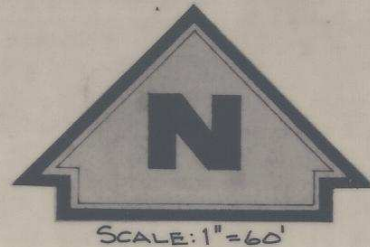

SCALE: 1" = 60'

LEGEND

- - SET 5/8 X 30" I. PIN W/ PLASTIC OR ALUMINUM CAP MARKED "WALLULIS AND ASSOC. INC."
 - - MONUMENTS FOUND AS NOTED
- BEARINGS BASED ON SOLAR OBSERVATION
SEE ATTACHED NARRATIVE OF SURVEY.

CA. ROAD NO. 893, 27' WIDE GRAVEL ROAD, GOOD CONDITION

DITCH TOP BANK

X HOMESITE EL =

W 1/4 COR SEC 9.

N 89°58'16" E - 238.71'
S 080.65'
E-W & SEC 9

E 1/4 COR SEC 9, FOUND BRASS CAP ON I. PIPE WITNESS CORNERS 29.54' EAST & 31.81' N.W. FROM CORNER POSITION.

RECEIVED BY

Umatilla County Surveyor

Date 8-17-82

Rec'd By BLS

No. 82-69-AP

REGISTERED PROFESSIONAL LAND SURVEYOR

William R. Wells
William R. Wells

OREGON
JULY 22, 1977
WILLIAM R. WELLS
1106

FD. 1" SQ. BOLT

PARCEL LOCATED IN THE SW 1/4 NW 1/4 SECTION 9, TWP 1 NORTH, RGE 33 EAST W.M., UMATILLA COUNTY, OREGON.

UMATILLA RESERVATION HOUSING AUTHORITY		PROJECT 12-07
APPLICANTS NAME: LEAH CONNER		SITE NO. 8
		DWELLING UNIT TYPE
WALLULIS & ASSOCIATES, INC., 213 S.W. EMIGRANT, PENDLETON, OR. (503)-276-1598		

82-69-AP

NARRATIVE OF SURVEY
for
LEAH CONNER

(See Map of Survey No.)

This survey was performed for the Umatilla Reservation Housing Authority as part of the 12-07 housing construction project.

The survey involved laying out a 1.0 acre, more or less, homesite on lands owned by Leah Conner. The West boundary of the site is the West line of Section 9, Township 1 North, Range 33 East, W. M. The South boundary of the site is the East-West centerline of said Section 9. The North and East boundaries of the site were located as shown on the Map of Survey and are within the exterior boundaries of the Leah Conner ownership.

The right-of-way for the County Road was excepted from the tract description.

RECEIVED BY

Umatilla County Surveyor

Date 8-17-82

Rec'd By BLS

No. 82-69-AL

REGISTERED
PROFESSIONAL
LAND SURVEYOR

William R. Wells

OREGON
JULY 22, 1977
WILLIAM R. WELLS
1106

William R. Wells