


NARRATIVE: The purpose of this survey is to repartition a portion of Blk 5, McNary Townsite Div. #2. (Lot 14 & N 1/2 Lot 13)

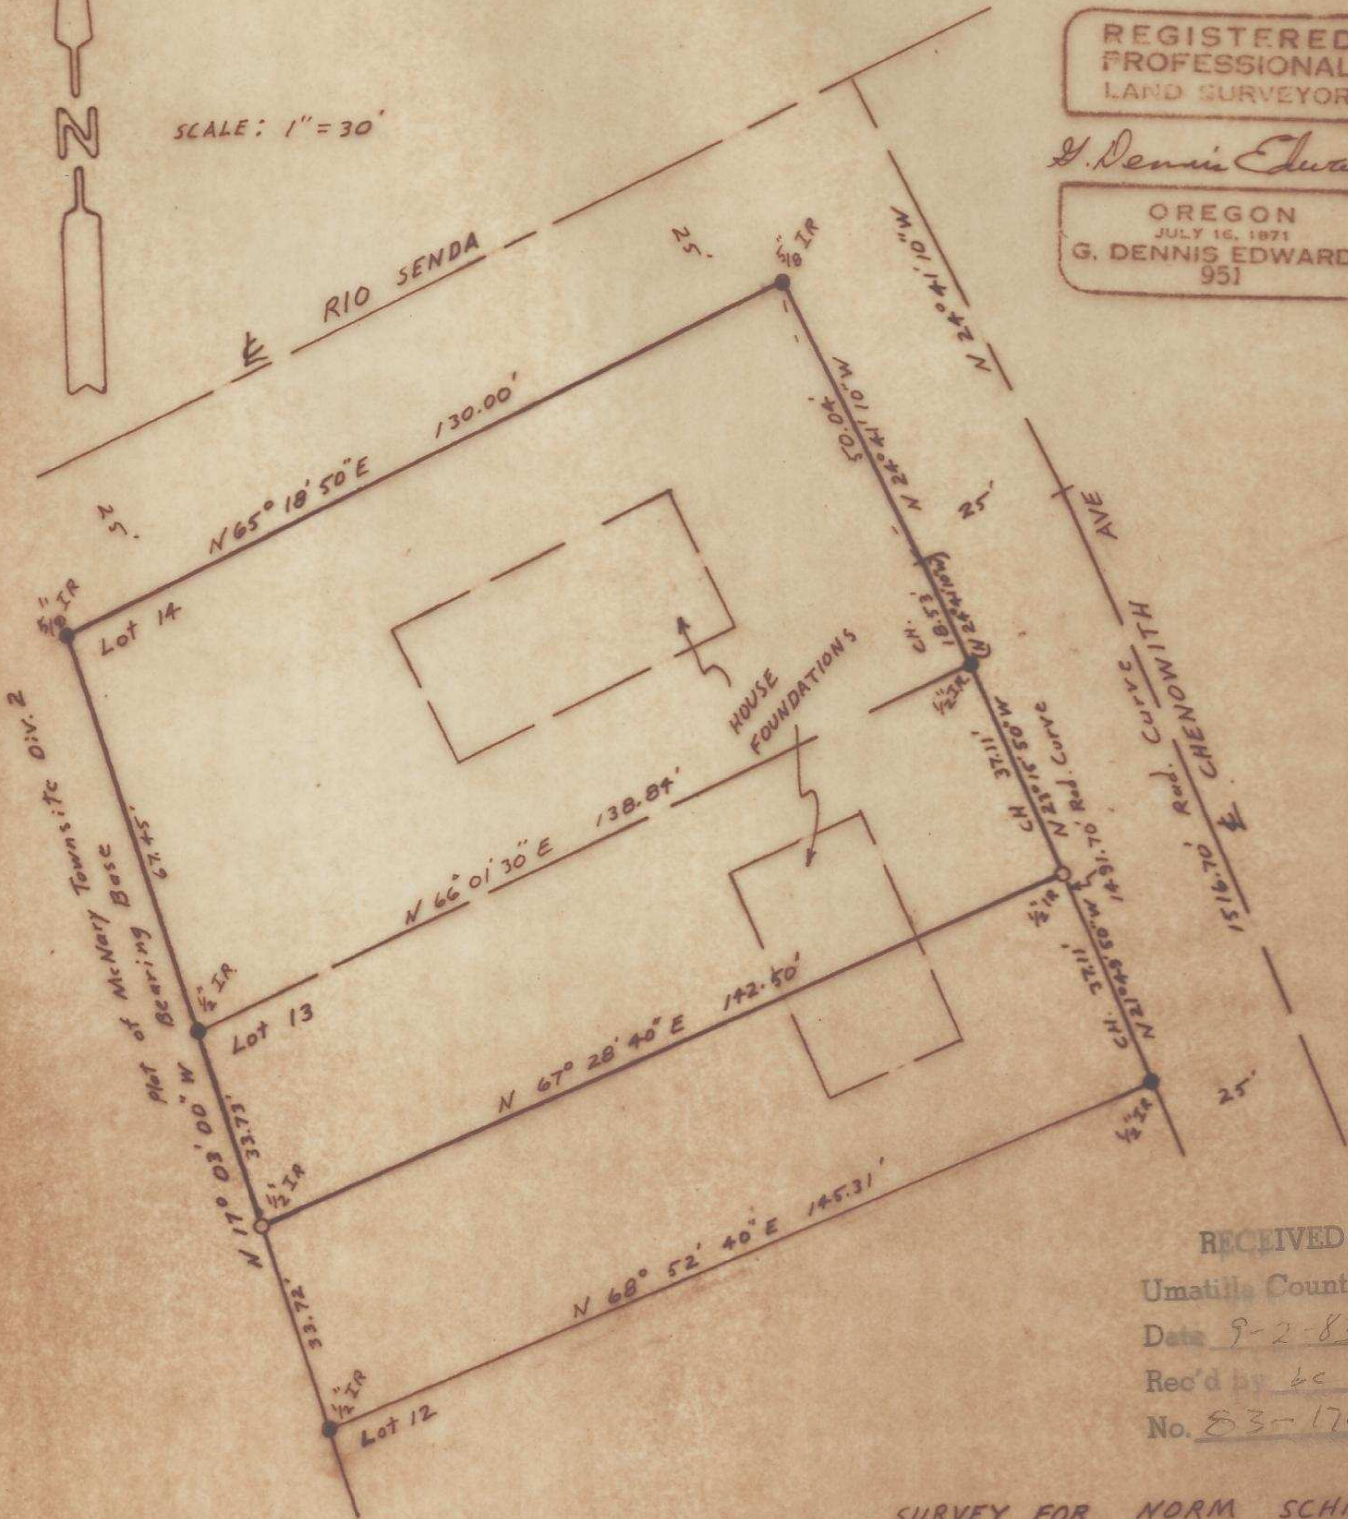

SCALE: 1" = 30'



REGISTERED
PROFESSIONAL
LAND SURVEYOR

G. Dennis Edwards

OREGON
JULY 16, 1871
G. DENNIS EDWARDS
951

RECEIVED BY

Umatilla County Surveyor

Date 9-2-83

Rec'd by bc

No. 83-170-A7

SURVEY FOR NORM SCHROTH
IN BLK 5, McNary Townsite Div #2
IN N 1/2 Sec 15, T5N, R28E, W.M.
CITY OF UMATILLA, UMATILLA CO., OR.
7/11/83 ● Monuments Fnd. Job #
○ Monuments Set 581070

EDWARDS SURVEYING PO. Box 763
567-3336 HERMISTON, OR.

83-170-A7