


State Highway

5

Alley

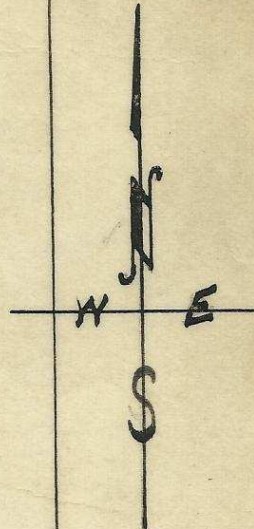

Plat showing Block 5 of  
Sailings Addition to

City of Weston, Oregon.

Dotted lines indicate Original Platting.

Solid lines indicate present boundary  
lines as they are established on  
the ground.

Scale 1 inch = 50 Feet.

Surveyed - Apr - May 1946. For Fred G. Lytall

By W. E. O. Origer.

4N3522AB

Pipe Cr. Bridge

Public ownership of highways  
and streets established  
through constant use by the public.

06-28-Ax