

9 owners -
12,

May. 20 30' 7.

N. 89° 42' E.

13


18

T. 5 N. - R. 29 E. W. M.
T. 5 N. - R. 30 E. W. M.

N. 89° 42' E -
40 ch.

40 ch.

Map showing
Sec. 13 - T. 5 N., R. 29 E. W. M.
Sec. 18 - T. 5 N., R. 30 E. W. M.
Surveyed, staked & Platted -
Mar. - 1955 -
By - W. E. O. Criger.
Scale: 4" = 1 mile.

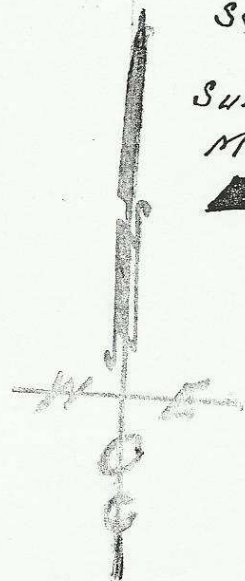

Dave Tonies

06-90-Ax

4