


Map of tracts located in  
 S.E/4 Sec. 29 T.4N., R.37 E., W.M.  
 Surveyed, staked and platted  
 Sept. 1952 by W.E.O. Criger.  
 Scale: 1 inch = 400 Feet.

Center. S.E/4 Sec. 29.

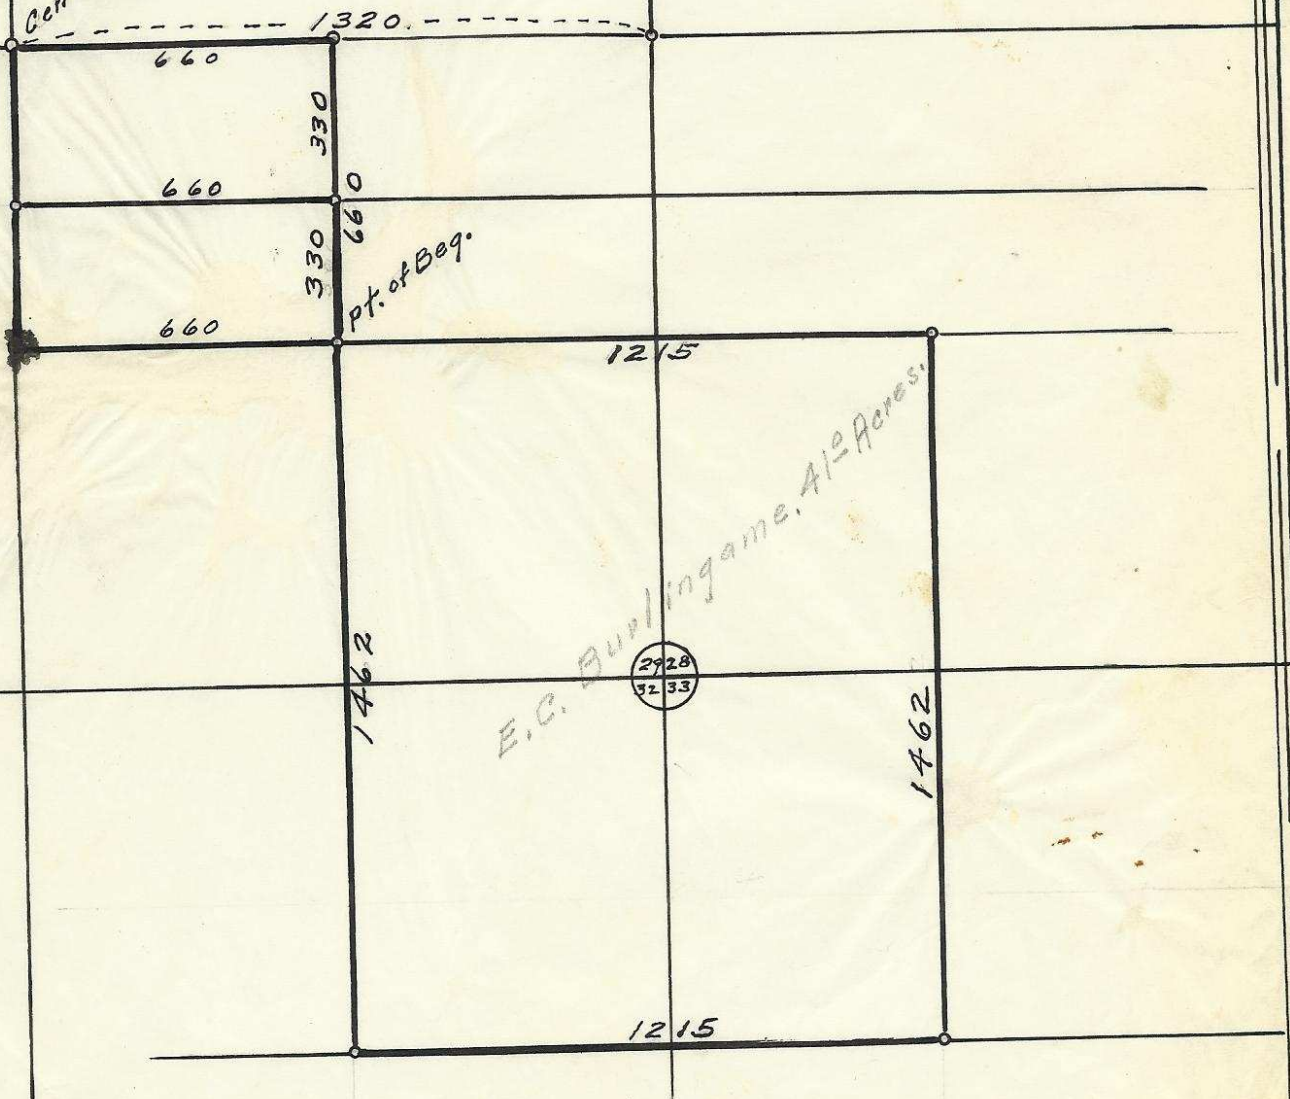

06-100-A8