
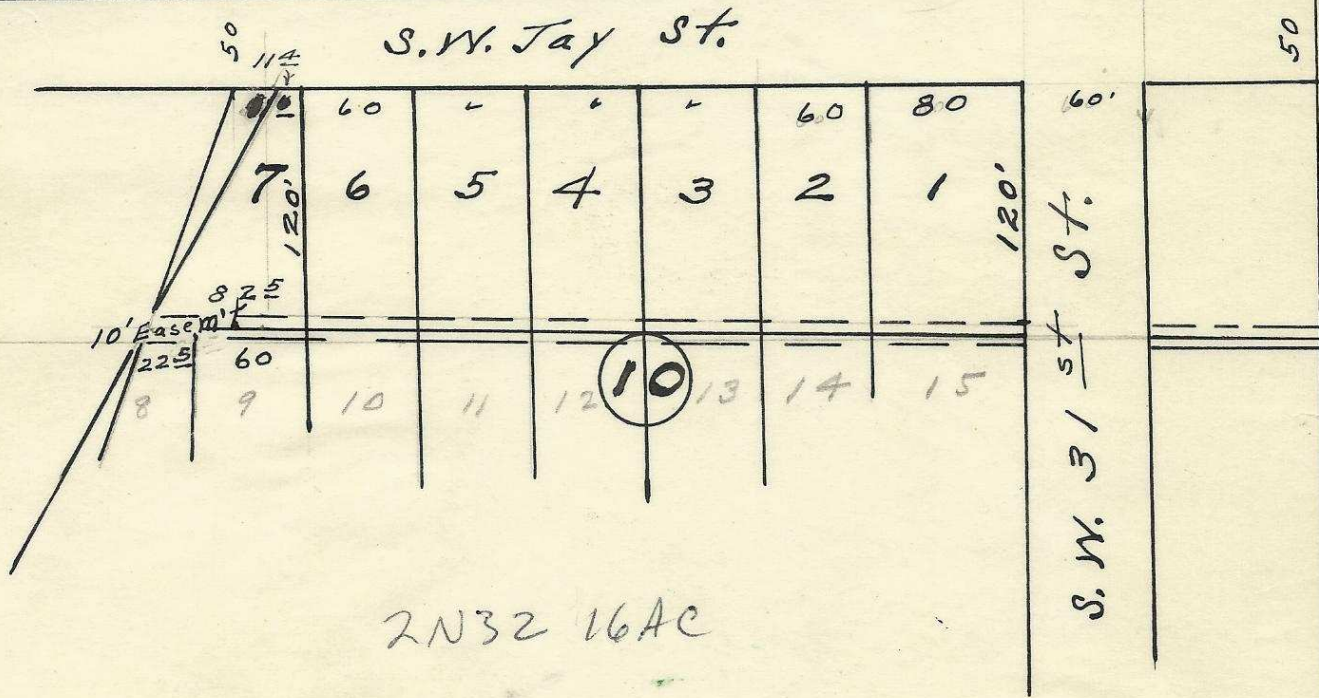


Plat Showing
 Part of Block 10 of Sherwood Heights
 Addition to the City of Pendleton, Ore.
 Surveyed, staked & platted - May-1953 -
 By W.E.O. Criger. -
 Scale: 1 inch = 100 Feet.

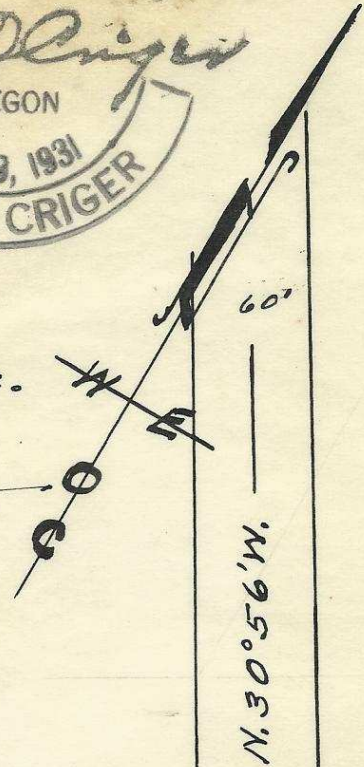

06-119-Ax