


276 17
 Tr. 1. B. 184, P. 636
 Tr. No. 1.
 Heilman & Uselton.

258 06
 Tr. Bk-183-P. 456-
 McKee-
 Geo. Heilman
 and
 H. C. Uselton. -

220 05
 Tr. 2.
 Heilman-
 & Uselton.

1829
 Agnes E. Smith
 BK-186-P483.

148 96

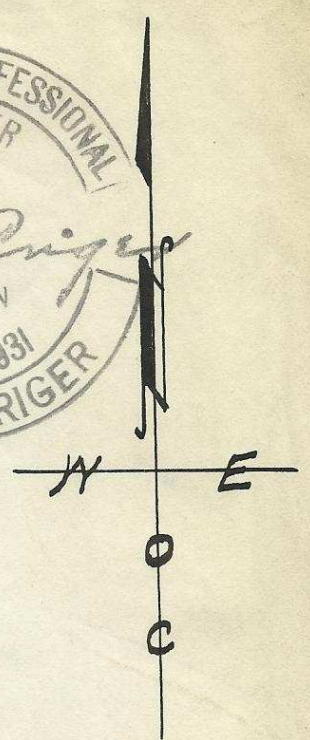

Map showing
 Tracts located in S/2 of S.W/4
 of Sec. 15, T. 5 N., R. 28 E. W.M.
 Hermiston, Umatilla Co., Ore.
 surveyed, staked & platted, Aug 1953.
 By W. E. O. Criger. Scale: 1 in. = 100 Ft.

06-226-Ax

4