




20310

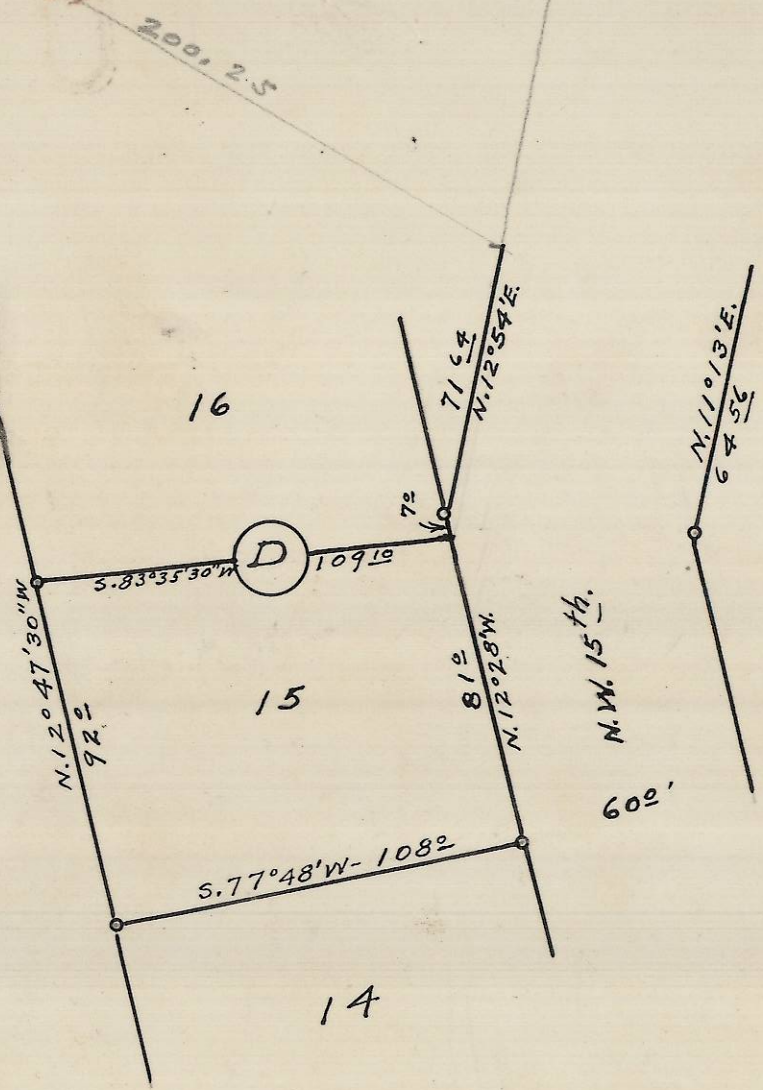

06-307-A+

Plat showing
 Lot 15 of Block D of
 Brown Courts Addition
 To City of Pendleton Oregon.
 Surveyed, staked and platted, Oct. 1951
 By W. E. O. Criger.
 Scale 1" = 50'