


9

10

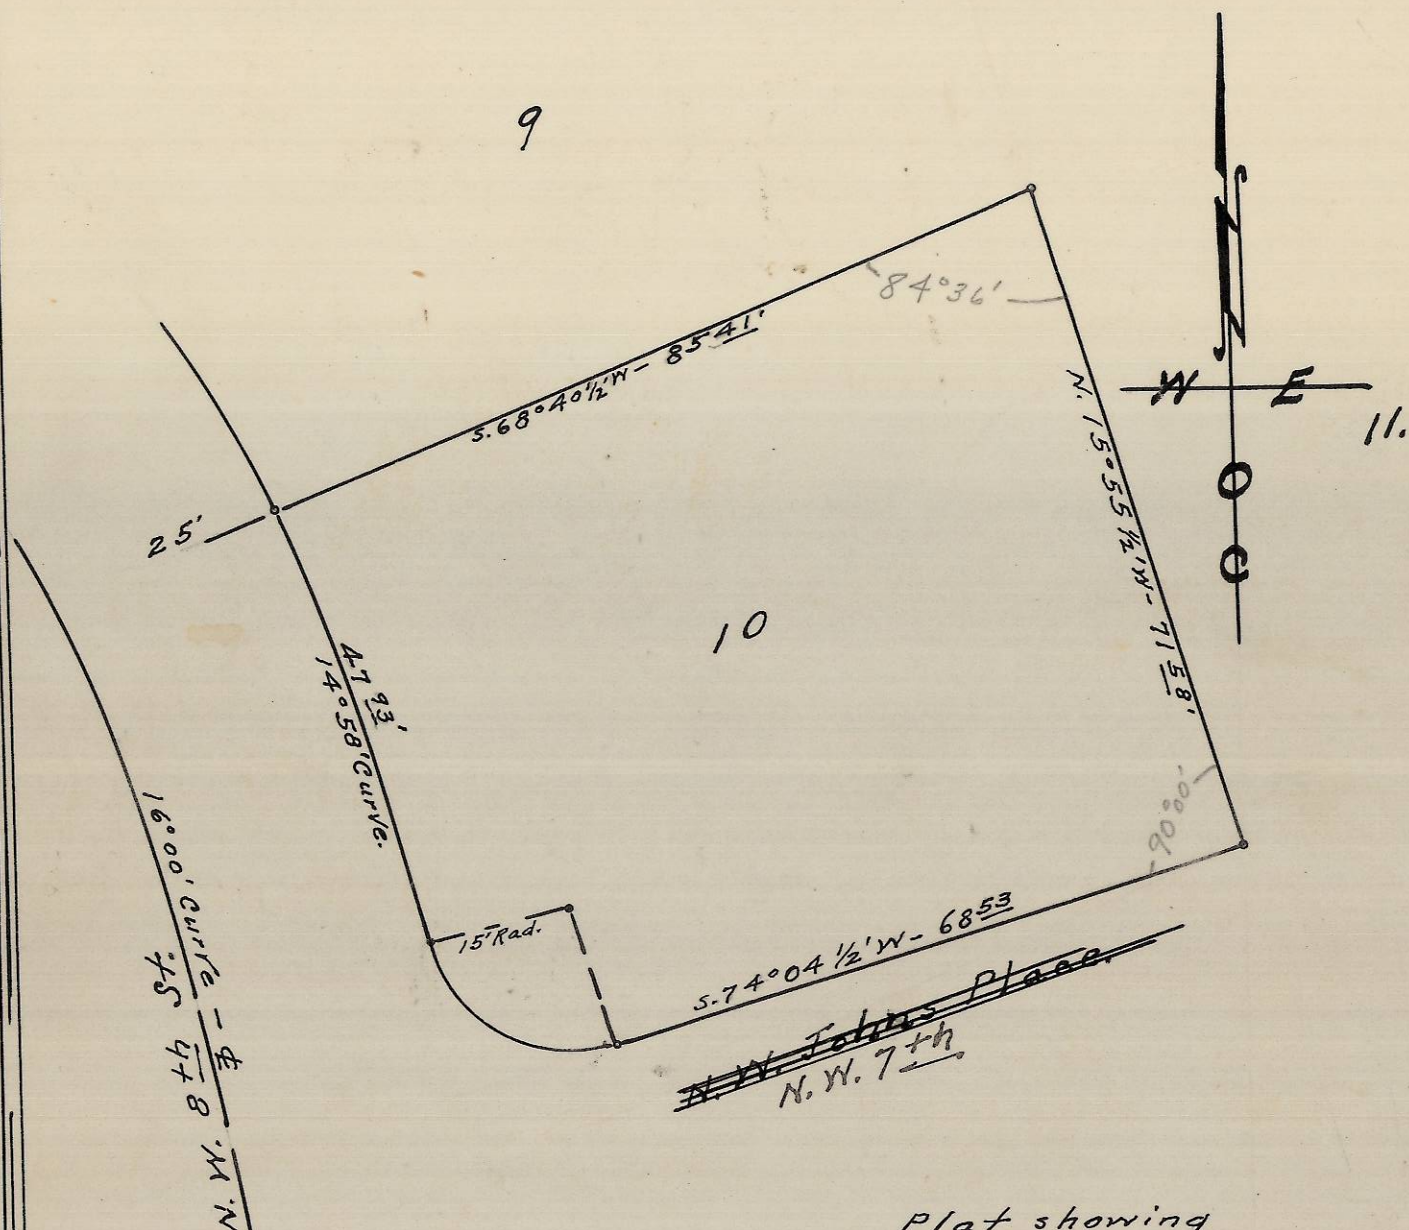

Plat showing
 Lot 10 of Block 2 of Curry's Addition
 To the City of Pendleton, Oregon.
 Surveyed, staked & platted - May 1952
 By W. E. O. Criger -
 Scale: 1" = 20'



06-319-AX

- Mrs. Carl Farrens -

4