



10

17

60

16

9

1

8

2

7

3

6


4

Vacated

S.E. 11th



S.E. Alexander
(Geer)

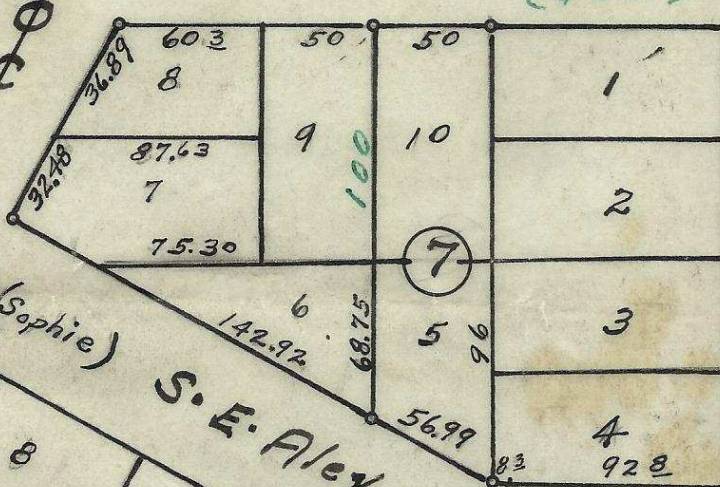

(Jeff Davis)

S.E. Byers

S.E. Alexander

S.E. 12th

(Lewis)

(Byers)

18

Plat of
3 portion of Byer's Park
Addition to City of Pendleton
Oregon. Surveyed, staked and
Platted June 1956. By W.E. O'Grady

2W32 2DC

06-330-AY

Scale: 1"=80'



Vacated

Vacated