


- 1/2" IRON PIN
- R.R. SPIKE

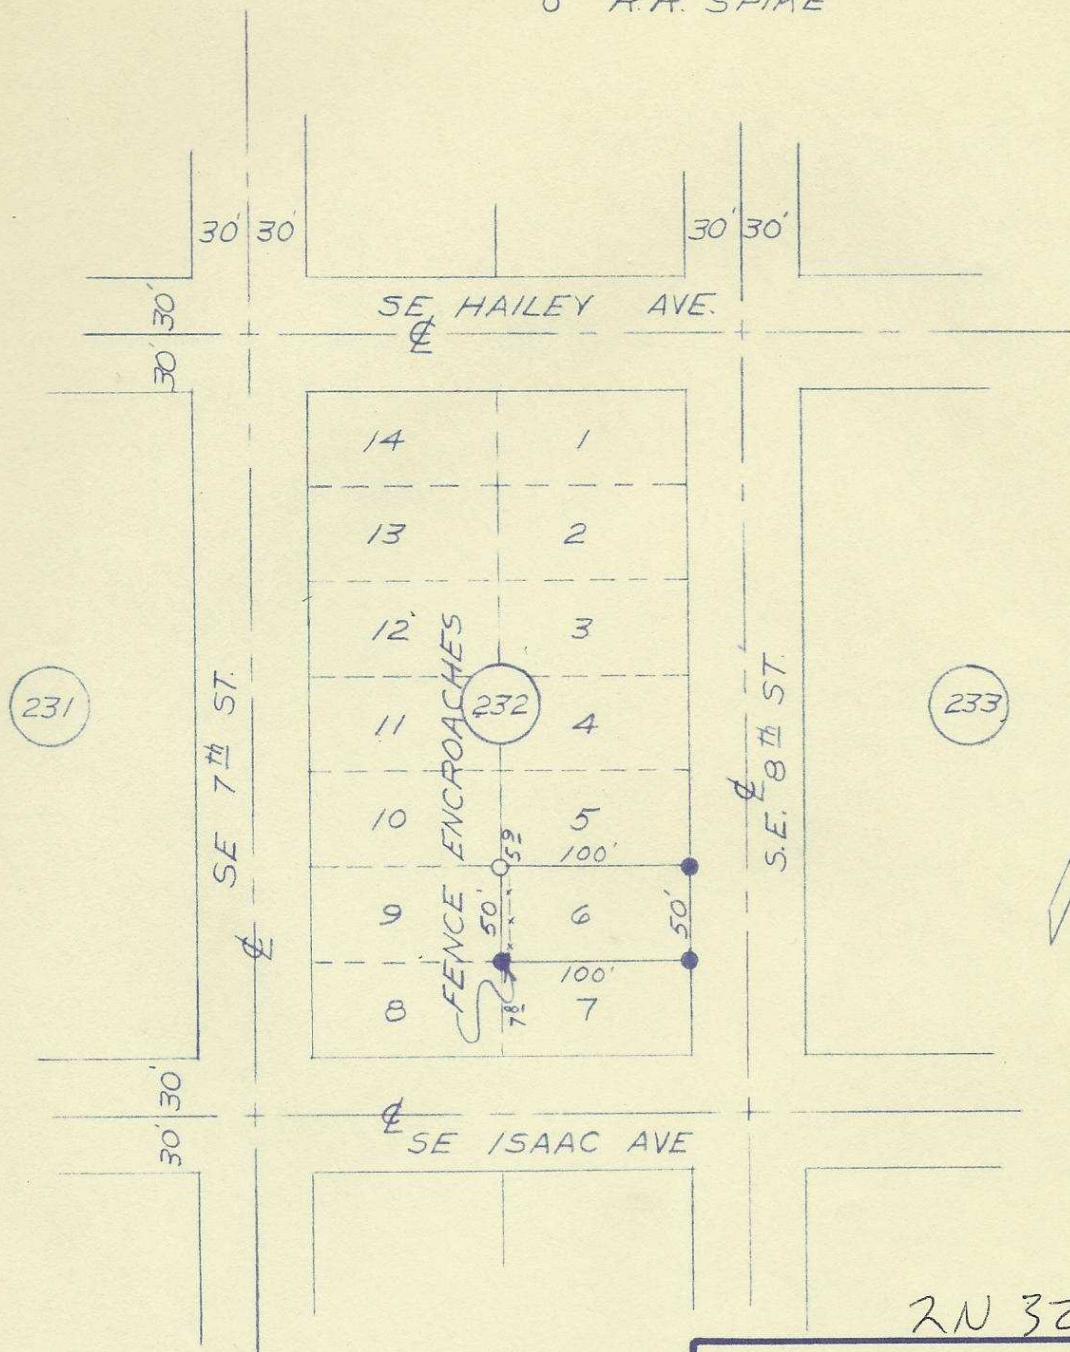

2N 32 11BD

REGISTERED
OREGON
LAND SURVEYOR

Wayne O. Harris
MAY 8, 1955
WAYNE O. HARRIS
346

06-537-Ax

HAYES AND HARRIS

SURVEY FOR

E.E. EWING

LOT 6 BLOCK 232

RESERVATION ADDITION
PENDLETON, OREGON

SCALE	DATE	DRN. BY	DRNG. NO.
1"=100'	9/2/63	LHA	63-181