


S.W. Emigrant Ave.

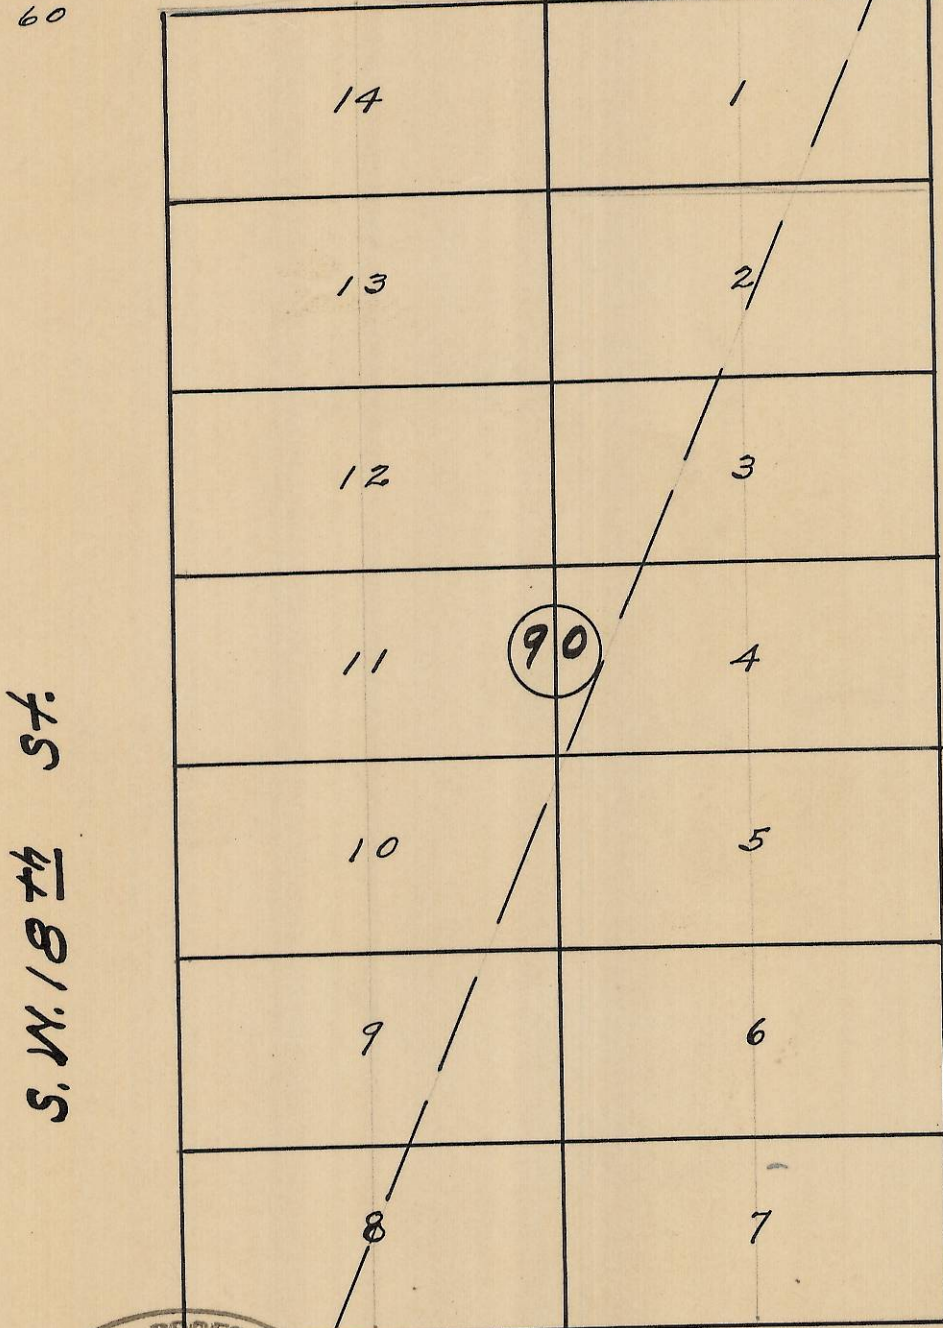

S.W. 18th St.

S.W. 17th St.

S.W. Frazier Ave.



plat showing Block 90 of Reservation
 Addition to the town, now City of
 Pendleton, Umatilla County, Oregon.
 Lot 4, surveyed, staked and platted - Sept. 1948.
 For - Walter Wagner - by W. E. O. Criger.
 Scale: 1 inch = 100 Feet.

Rec'd. 2/21/13
 J. Holant
 13-077-Ax
 2N 32 10 CB

