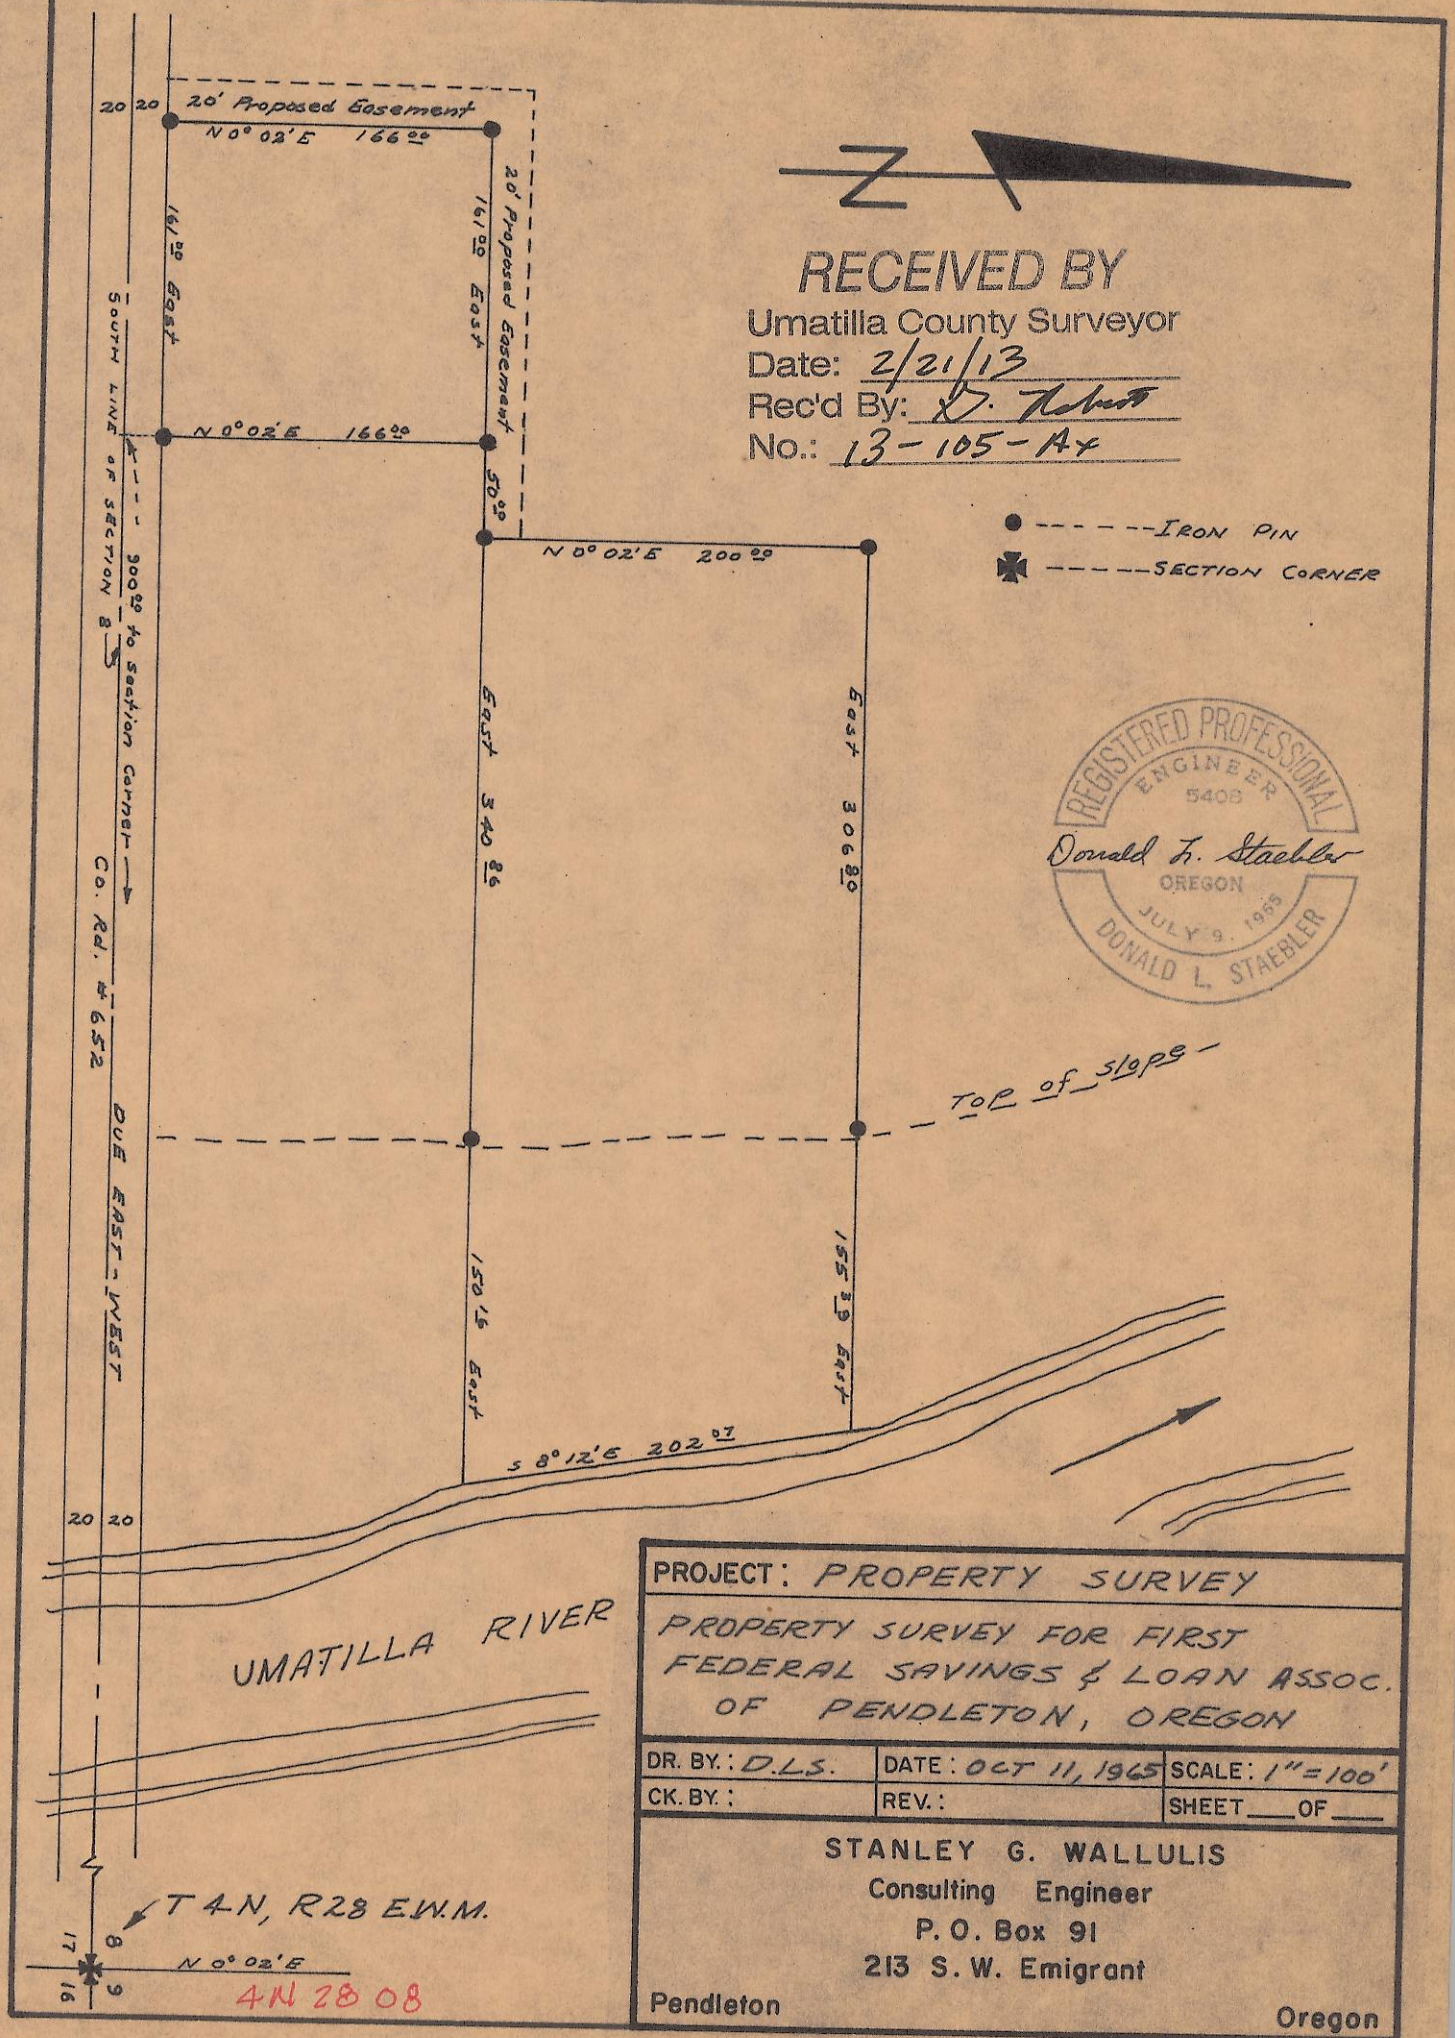

RECEIVED BY
Umatilla County Surveyor
Date: 2/21/13
Rec'd By: D. Robert
No.: 13-105-Ax

PROJECT: PROPERTY SURVEY

PROPERTY SURVEY FOR FIRST FEDERAL SAVINGS & LOAN ASSOC. OF PENDLETON, OREGON

DR. BY.: D.L.S.	DATE: OCT 11, 1965	SCALE: 1" = 100'
CK. BY.:	REV.:	SHEET ___ OF ___

STANLEY G. WALLULIS
Consulting Engineer
P. O. Box 91
213 S. W. Emigrant
Pendleton Oregon

Give to R.P. Thompson