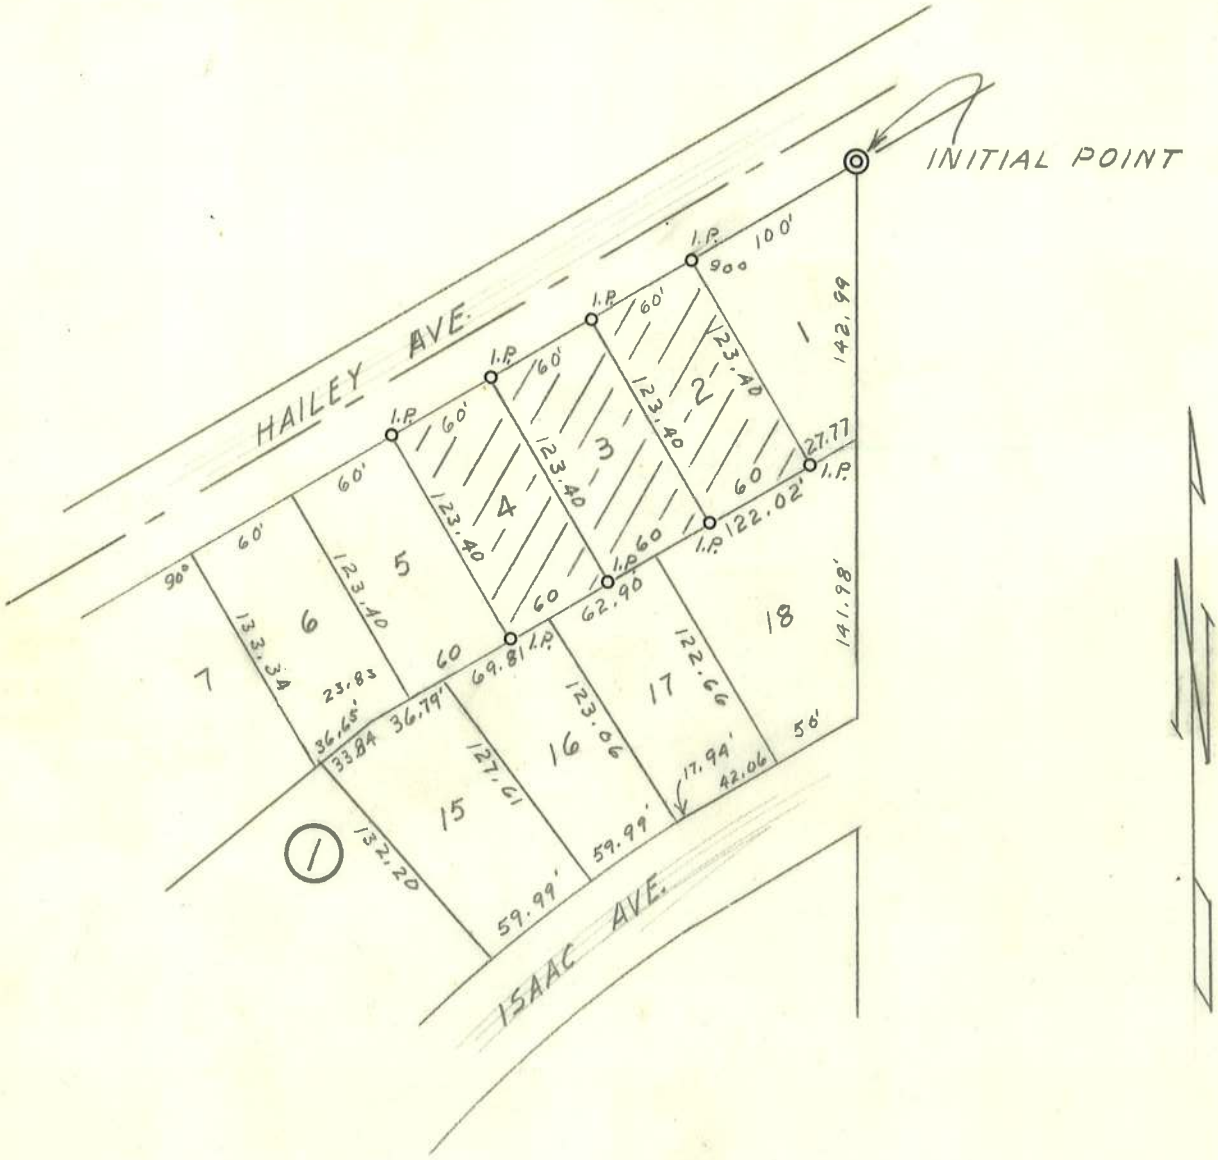

REGISTERED
OREGON
LAND SURVEYOR

Wayne O Harris

MAY 6, 1955
WAYNE O. HARRIS
346

14-039-AX

HAYES AND HARRIS

Survey For

CANNADY CONST. CO.

Lots 2,3,&4 Block 1
Crestview Addition
Pendleton, Oregon

Scale	Date	Drn. By	Drng. No.
1"-100'	1/20/59	WOH	59-78