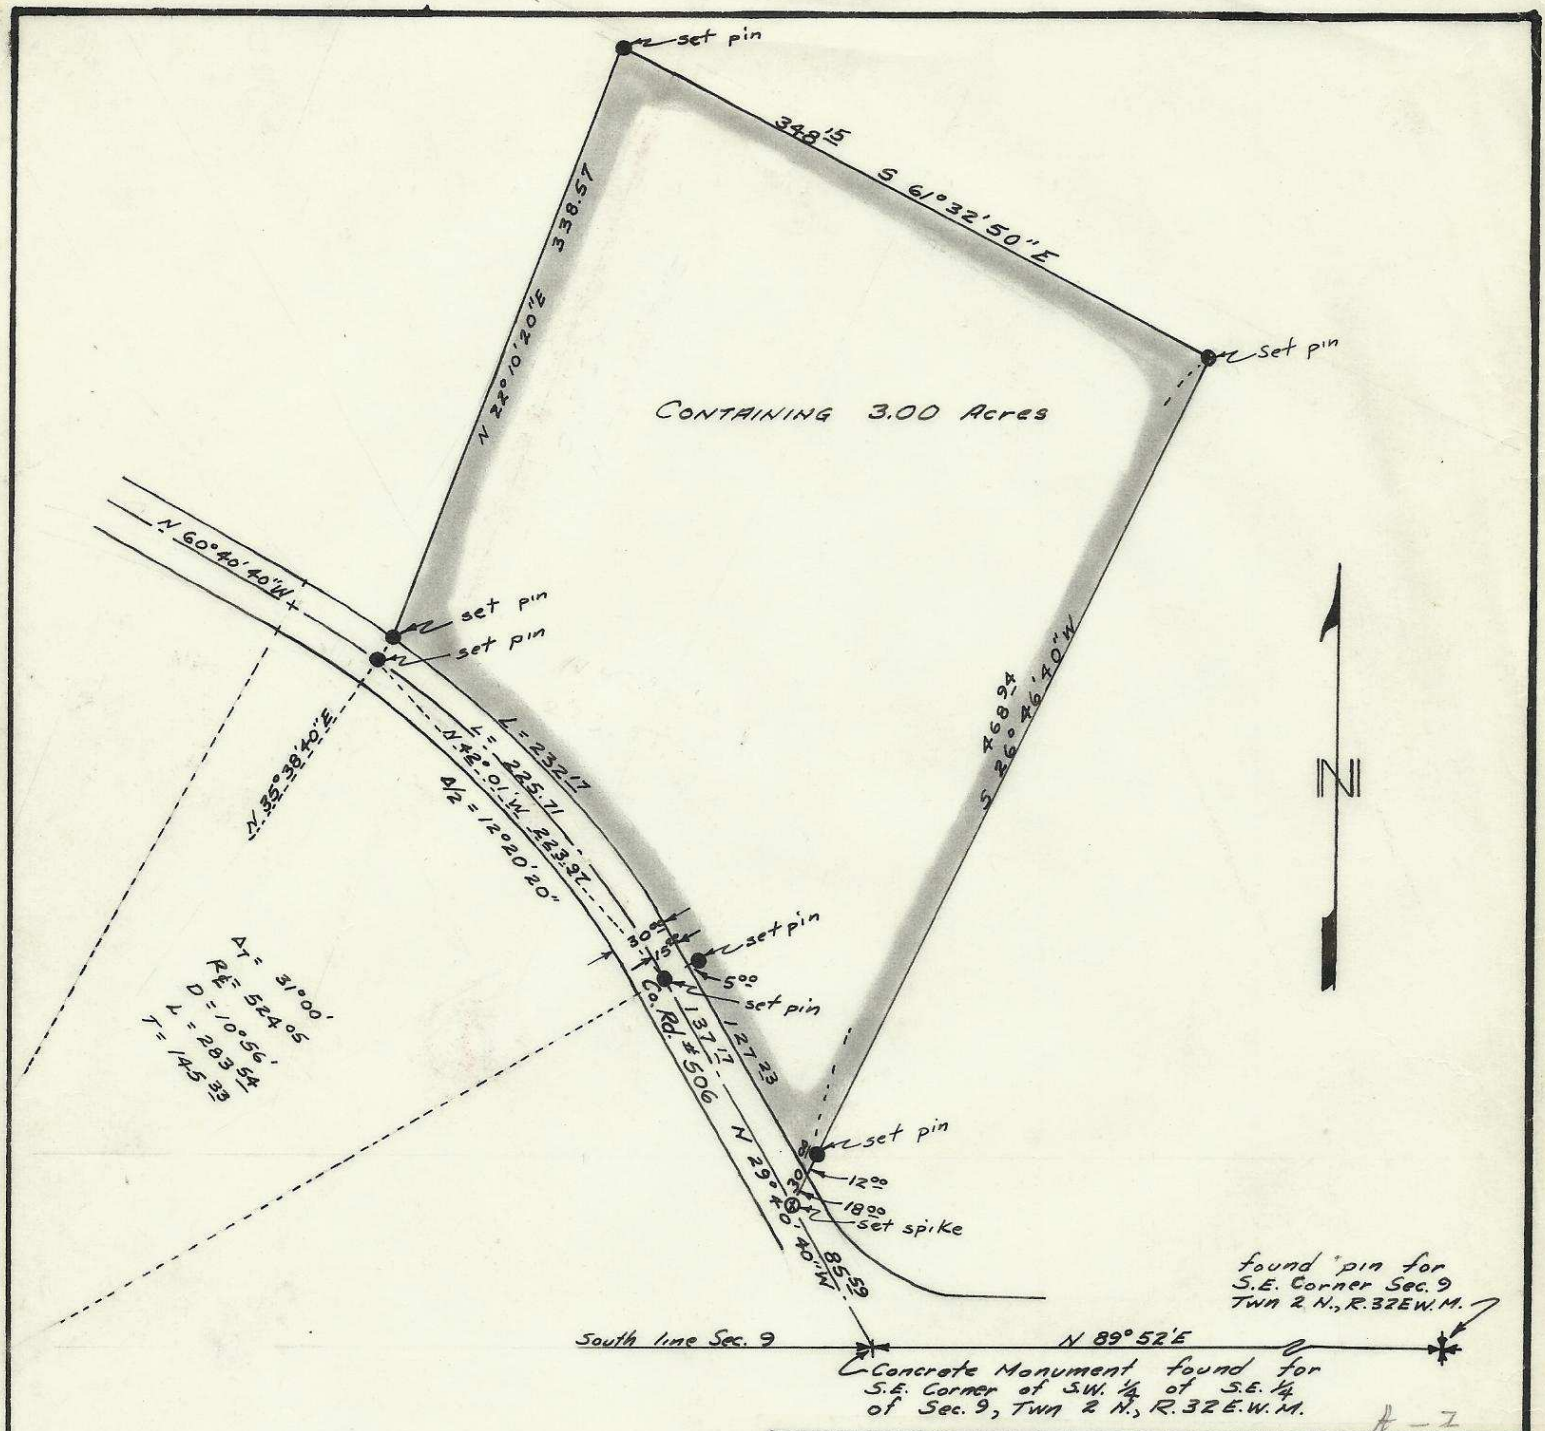

A-1

REGISTERED PROFESSIONAL ENGINEER
3758
Stanley G. Wallulis
OREGON
OCT. 22, 1954
STANLEY G. WALLULIS

PROJECT: SURVEY FOR BUD PETERSON

A TRACT OF LAND LOCATED IN THE SE 1/4 OF SECTION 9, TOWNSHIP 2 NORTH, R.32, E.W.M.

DR. BY.: S.G.W.	DATE: 4-10-64	SCALE: 1" = 100'
CK. BY.: S.G.W.	REV.:	SHEET 1 OF 1

STANLEY G. WALLULIS
Consulting Engineer
P. O. Box 91
213 S. W. Emigrant
Pendleton Oregon

A-2

A-2-Ax