


E S.W. Isaac Ave

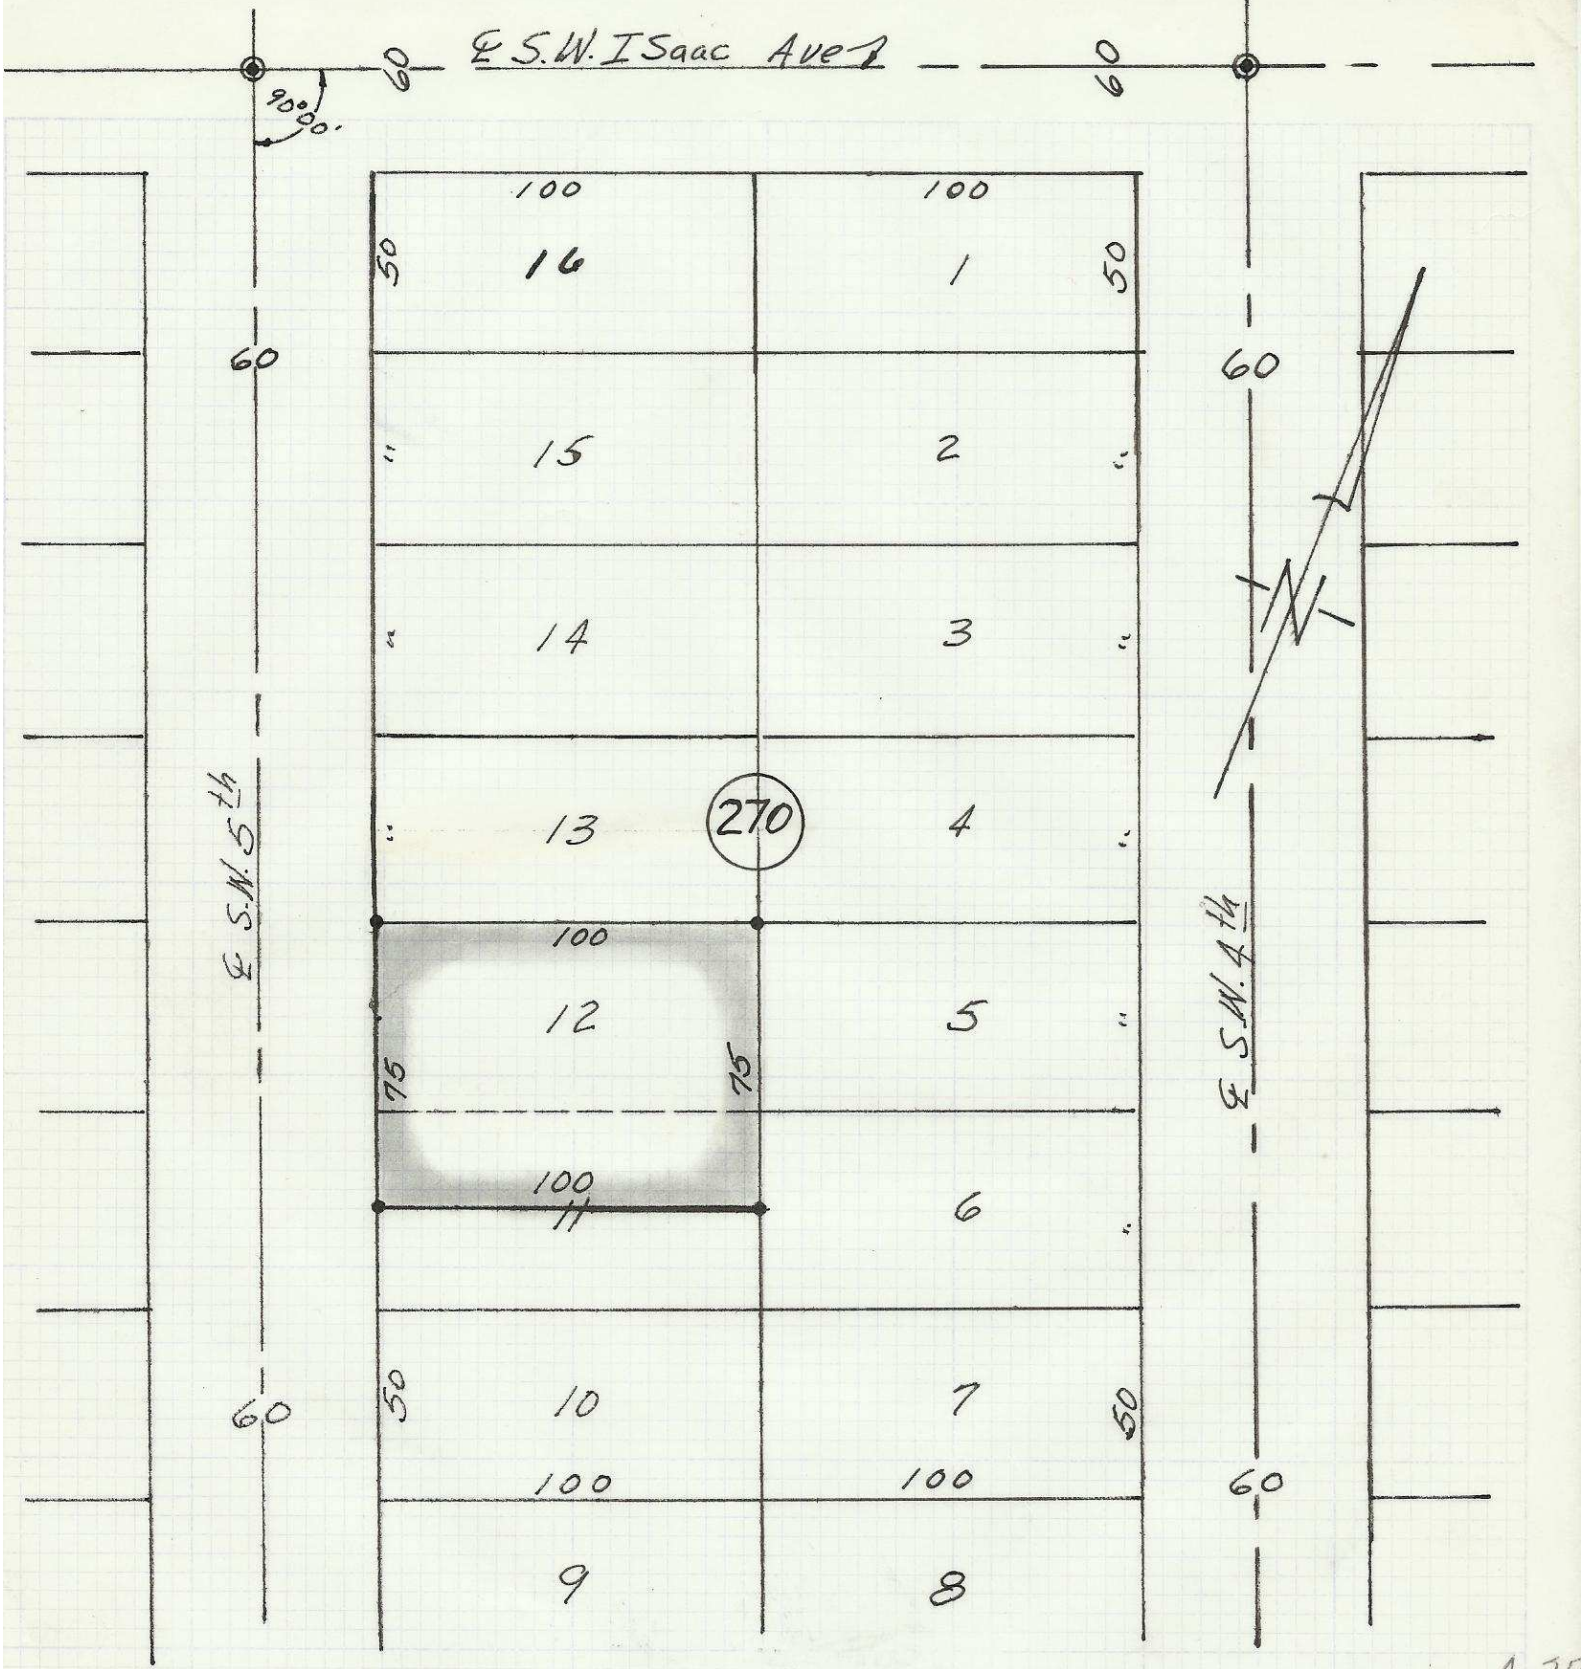

"⊙" Indicates Mon.s Found

"•" Indicates Iron pins Set

REGISTERED  
**OREGON**  
 LAND SURVEYOR

*Ralph P. Thompson*

MAY 13, 1960  
 RALPH P. THOMPSON  
 506

Property Survey For  
 PENDLETON REALTY  
 in Reservation Add.

Date: 8/20/64 | Scale: 1"=50'

**R. P. THOMPSON**

REGISTERED PROFESSIONAL LAND SURVEYOR  
 13 S. E. COURT AVE, PENDLETON, OREGON

A-20-A x