


E N.W. CARDEN AVE. ↘

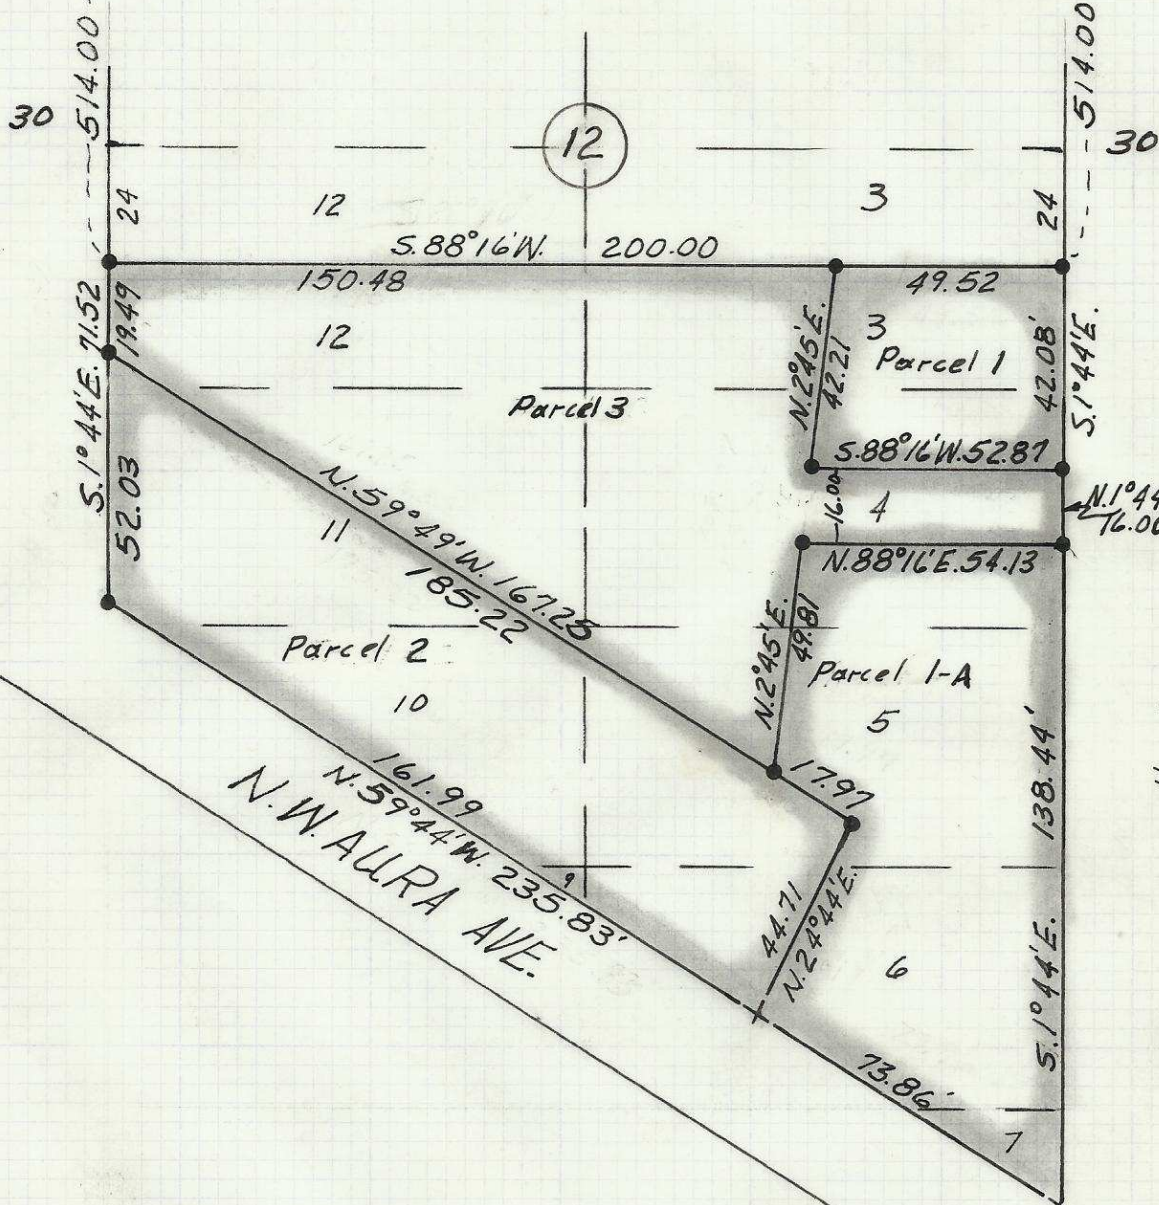

E N.W. 11th



E N.W. 10th ↘

"●" Indicates Iron Pins set
" + " Indicates Plus in Sidewalk

REGISTERED
OREGON
LAND SURVEYOR

Ralph P. Thompson

MAY 13, 1960
RALPH P. THOMPSON
506

Property Survey
IN BLK. 12 HOUSERS ADD.
Pendleton Oregon

Date: 4-13-65 Scale: 1" = 40'

R. P. THOMPSON
REGISTERED PROFESSIONAL LAND SURVEYOR
13 S. E. COURT AVE. PENDLETON, OREGON