


D-10-Ax

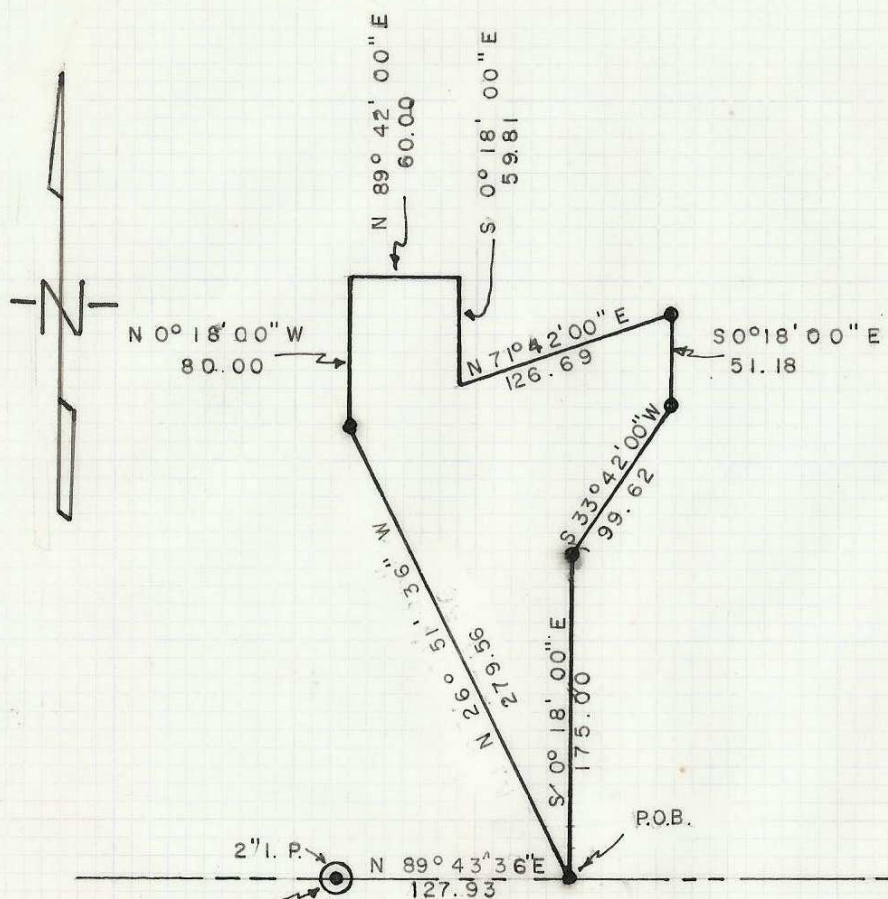

Note: Bearings are based on the south line of section 4 as being N.89° 43' 36\"/>

S.W. COR. S.E. 1/4 S.E. 1/4  
SEC. 4 T2N R 32 EWM

4	3
9	1.0

- Indicates Monuments Found
- Indicates I. P. Set

REGISTERED  
**OREGON**  
LAND SURVEYOR

*Ralph P. Thompson*

MAY 13, 1960  
RALPH P. THOMPSON  
506

SURVEY FOR  
D. R. SATTERWHITE  
in the S.E. 1/4 of the S.E. 1/4  
SEC. 4 T2N R 32 EWM

Scale: 1" = 100'      Date: 3/1/67

**RALPH THOMPSON**  
REGISTERED LAND SURVEYOR  
P. O. BOX 1082 - PENDLETON, ORE. 97801

10 3541  
SURVEYOR  
10 2

D-10