


MAP OF SURVEY
IN
SECTION 16, T2N, R32E, W.M.
UMATILLA COUNTY, OREGON

D-21-Ax

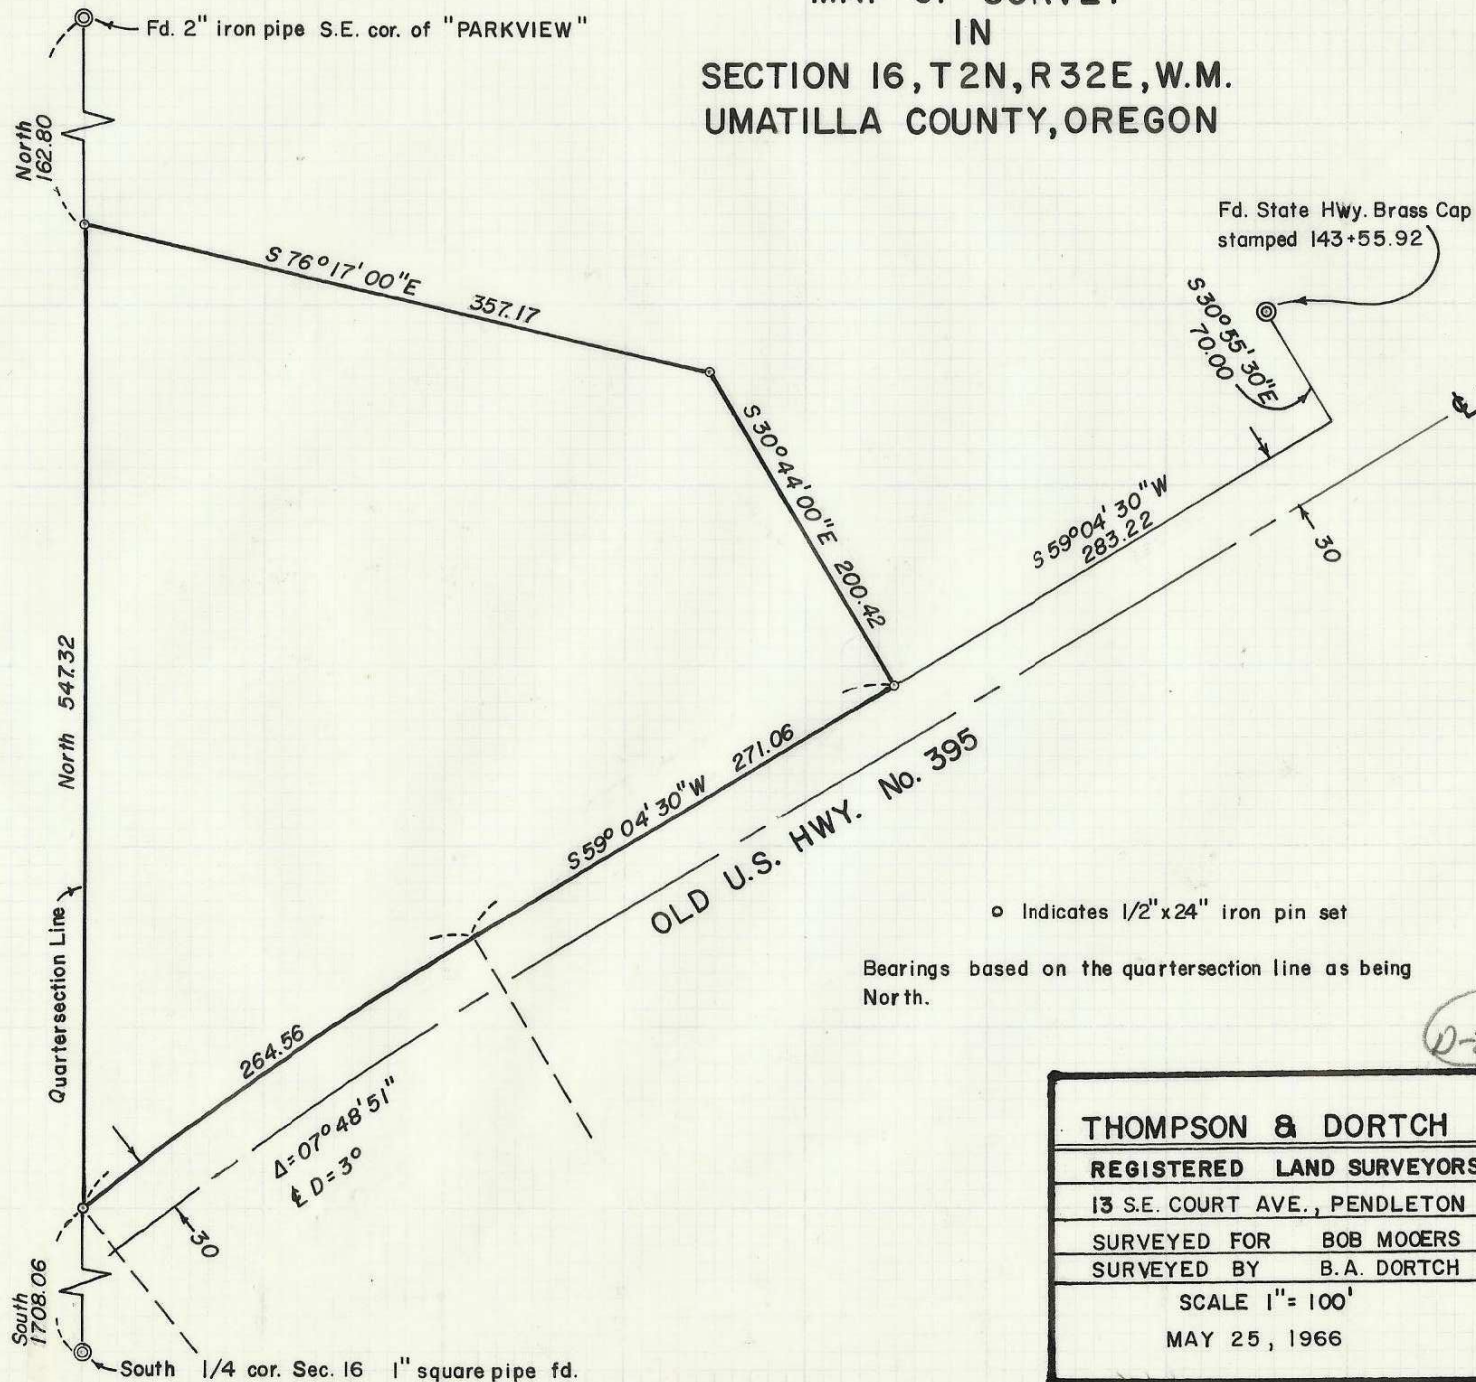

THOMPSON & DORTCH
REGISTERED LAND SURVEYORS
 13 S.E. COURT AVE., PENDLETON
 SURVEYED FOR BOB MOOERS
 SURVEYED BY B.A. DORTCH
 SCALE 1" = 100'
 MAY 25, 1966

D-21

160A

ALBANY'S GUIDE LINE TO THE HIGH NON-REPRODUCIBLE TO 1941 MEYER & FISHER CO. MADE IN U.S.A.