
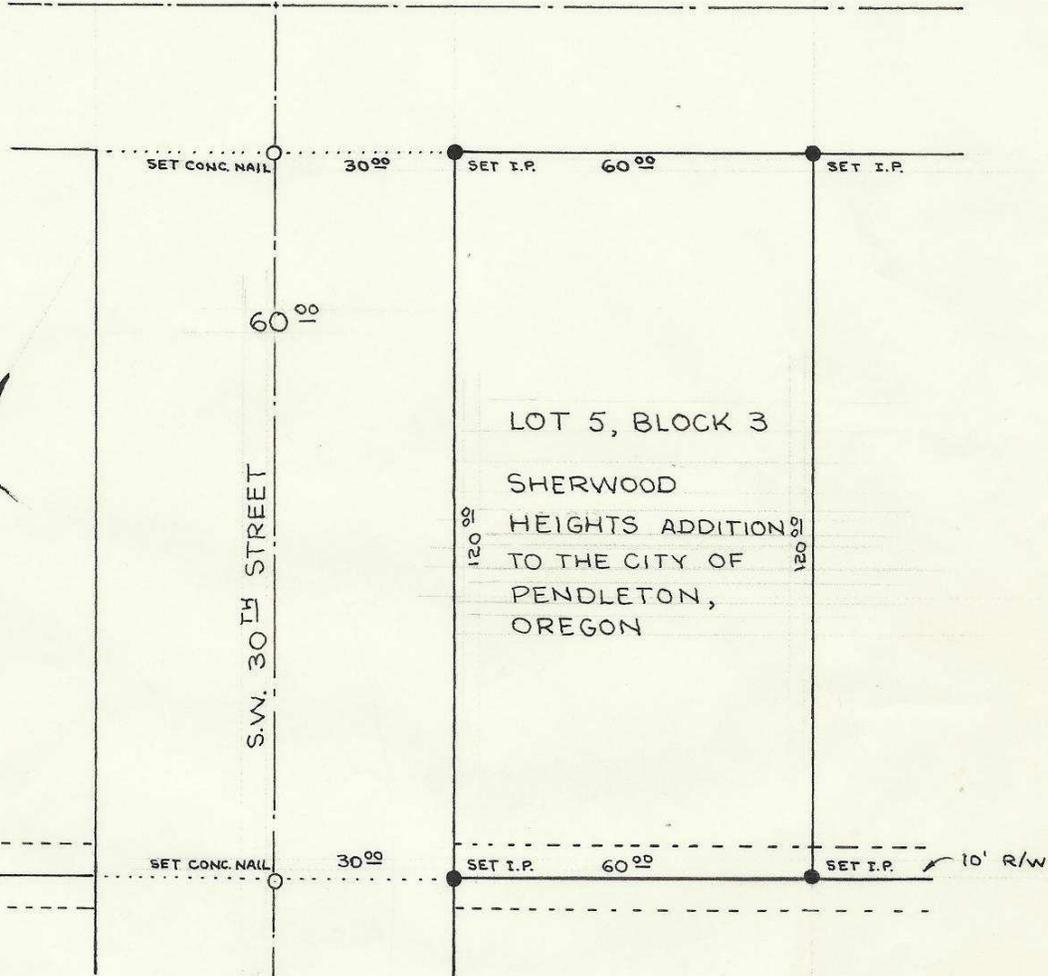


S.W. HAILEY AVENUE - COUNTY ROAD NO. 397

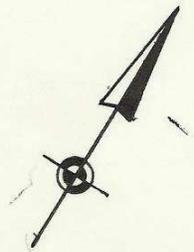

Donald L. Staebler
REGISTERED PROFESSIONAL ENGINEER 5408 OREGON
JULY 9, 1965
DONALD L. STAEBLER

PROPERTY LINE SURVEY
FOR JOSEPH SMITH

DR. BY: KWC	DATE: 3-16-68	SCALE: 1" = 30'
CK. BY: DLS	REV :	SHEET 1 OF 1

DONALD L. STAEBLER
CONSULTING ENGINEER
P.O. BOX 91
213 S.W. EMIGRANT
PENDLETON OREGON

NW 1/4 NE 1/4 Sec. 16, 2N32

E-18-A ✓