


NOTE: 1" I. Pipe at stateline
 15 | 14
 was found by chaining down from MP 21. The latest information on file was that the corner was a stone. Since it was not, I checked down to the next reliable corner and found that it lined up with the fence corner thus establishing the pipe as the corner

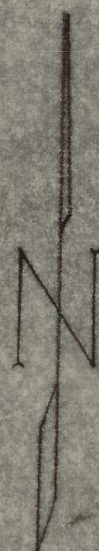

REGISTERED
 OREGON
 LAND SURVEYOR
David H. Kulis
 JULY 17, 1970
 DAVID H. KRUMBEIN
 923

| | | | |
|---------------------------------|--------|---------|----------|
| WAYNE HARRIS CO. INC. | | | |
| SURVEY FOR | | | |
| UMATILLA COUNTY ROAD DEPARTMENT | | | |
| SECTIONS 14 & 15 | | | |
| T6N, R34E W.M. | | | |
| SCALE | DATE | DRN. BY | DRN. NO. |
| 1"=800' | 8-1-71 | SEM | 71-323 |

#67-Ax