


H-841-Ax

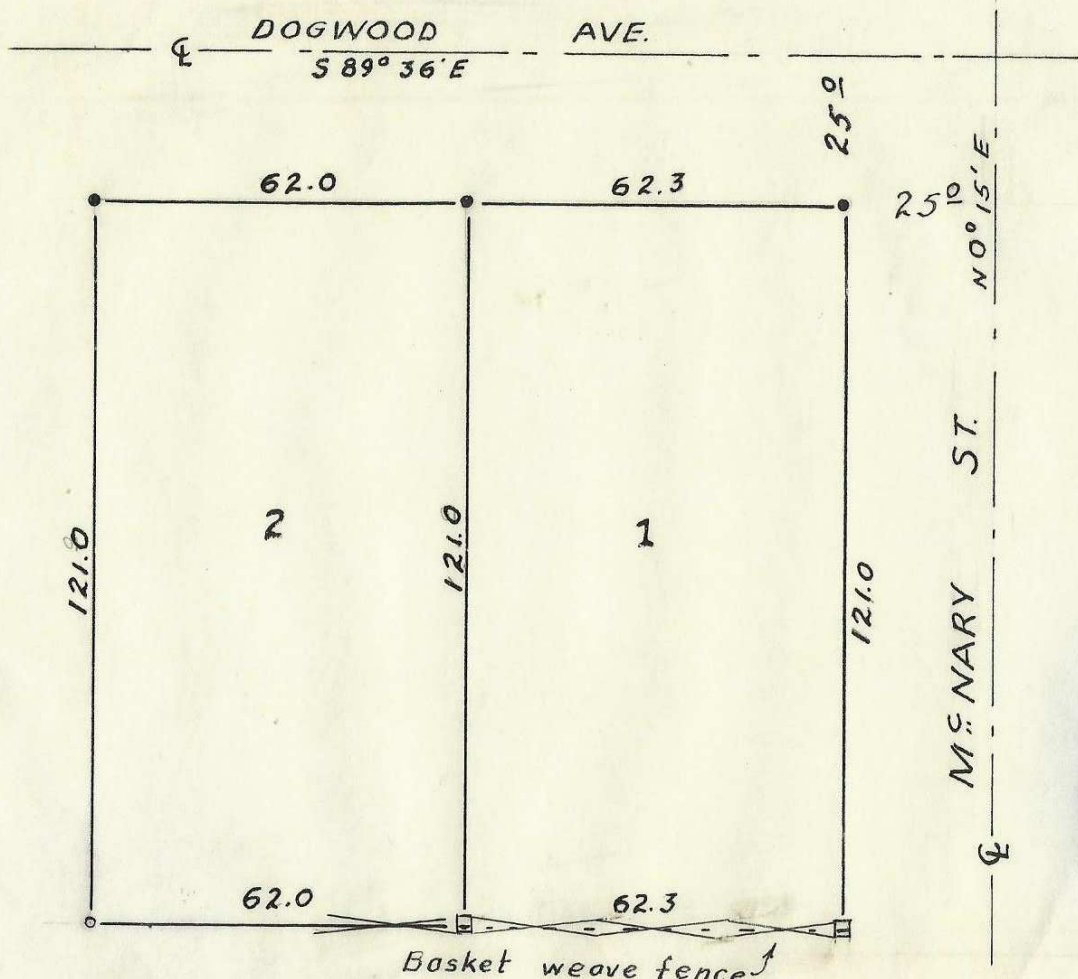

- Points Found $\frac{1}{2}$ " Pins
 - Point set $\frac{5}{8}$ " x 24" Rebar
 - ▣ 4" x 4" Fence Post(s) on lot corners
- Bearings & other survey data taken from subdivision plat on file in city hall.

SURVEY FOR ZAMINDAR CORP.
 PLOT PLAN
 LOTS 1 & 2 BLOCK A
 LAKEVIEW TRACTS
 HERMISTON, OREGON
 Scale 1" = 30' Date 6/27/72

H-84