



Sec. 24, T6N, R35E.

H-100-A

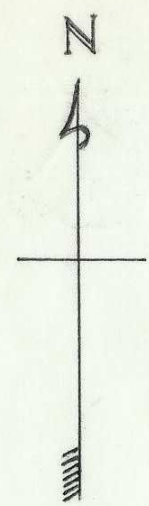

Scale: 1" = 50'

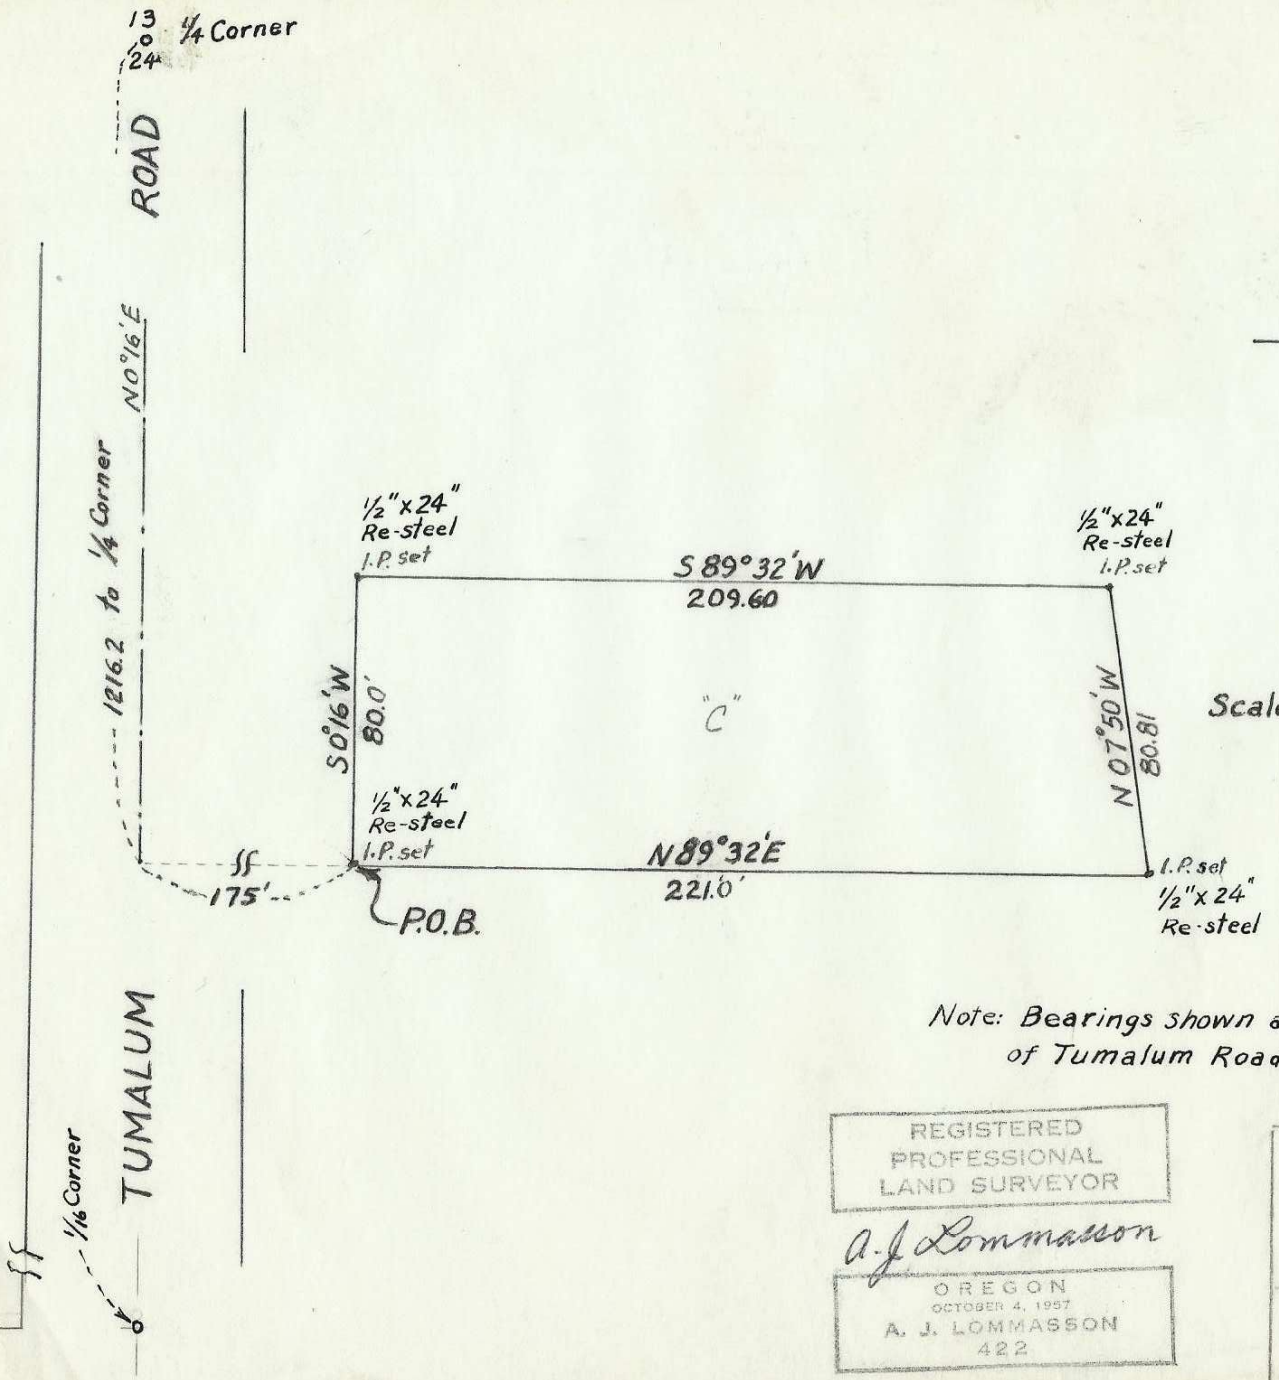

Note: Bearings shown are based on centerline of Tumalum Road which is $N 0^{\circ} 16' E$.

REGISTERED PROFESSIONAL LAND SURVEYOR

A. J. Lommasson

OREGON
OCTOBER 4, 1957
A. J. LOMMASSON
422

ALLEN J. LOMMASSON
Registered Surveyor
142 THORNE
WALLA WALLA, WASHINGTON

Survey for
JOHN R. STARLIN
4/8/72

H-100