H-135-Av

SURVEY FOR

ROBERT J. MILLER
J.W. HEWITT and
MILTON FREEWATER

Scale 1" = 100' Mar. 19, 1968

Guy W. Streamer Jr.
PROFESSIONAL ENGINEER

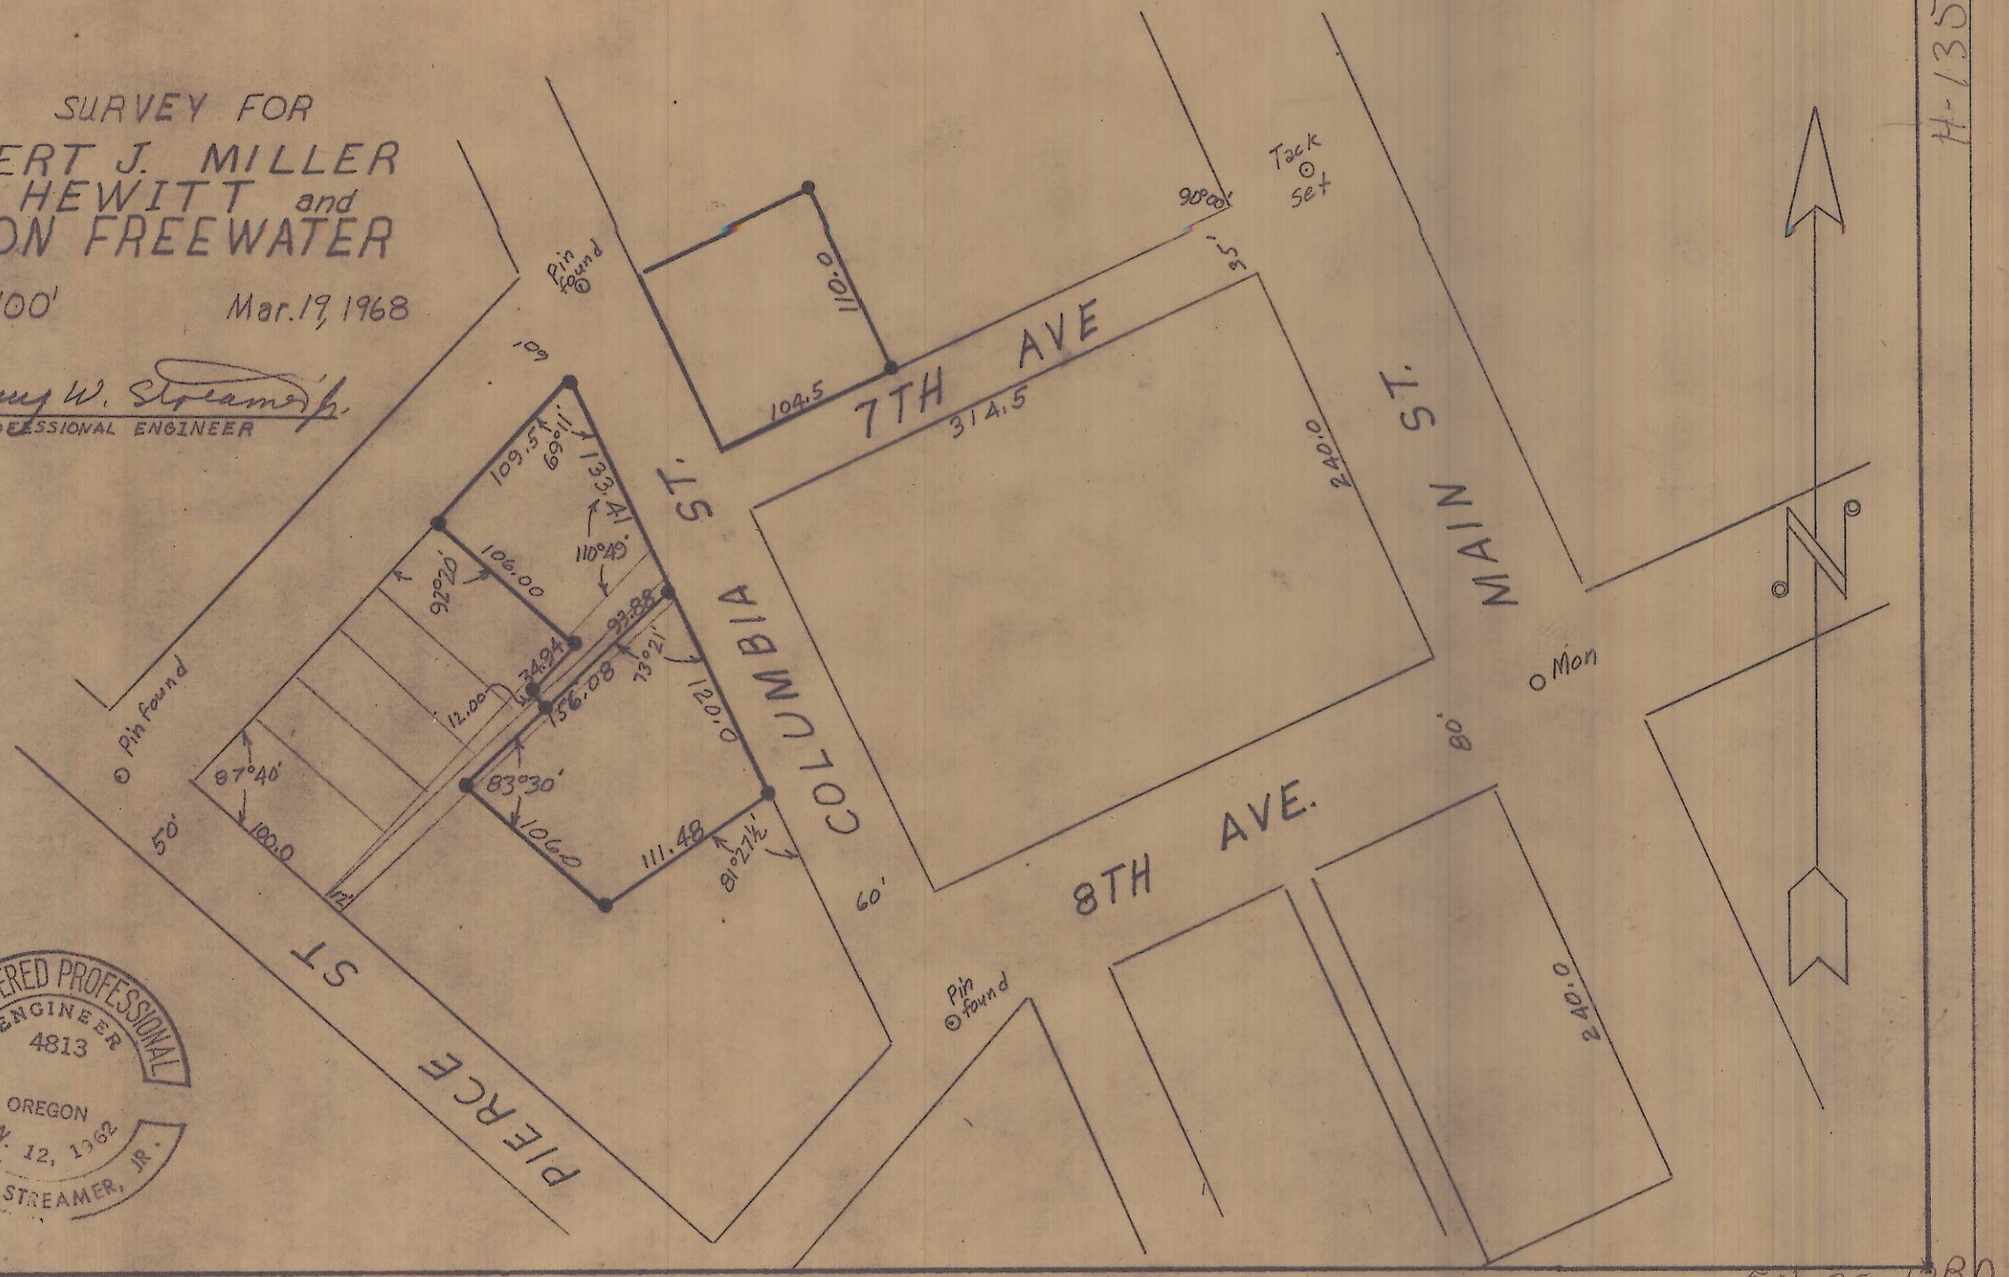

REGISTERED PROFESSIONAL ENGINEER
4813
OREGON
JAN. 12, 1962
GUY W. STREAMER, JR.

5N-3E-13BD
Survey 275 276 382
H-135