


136-AX

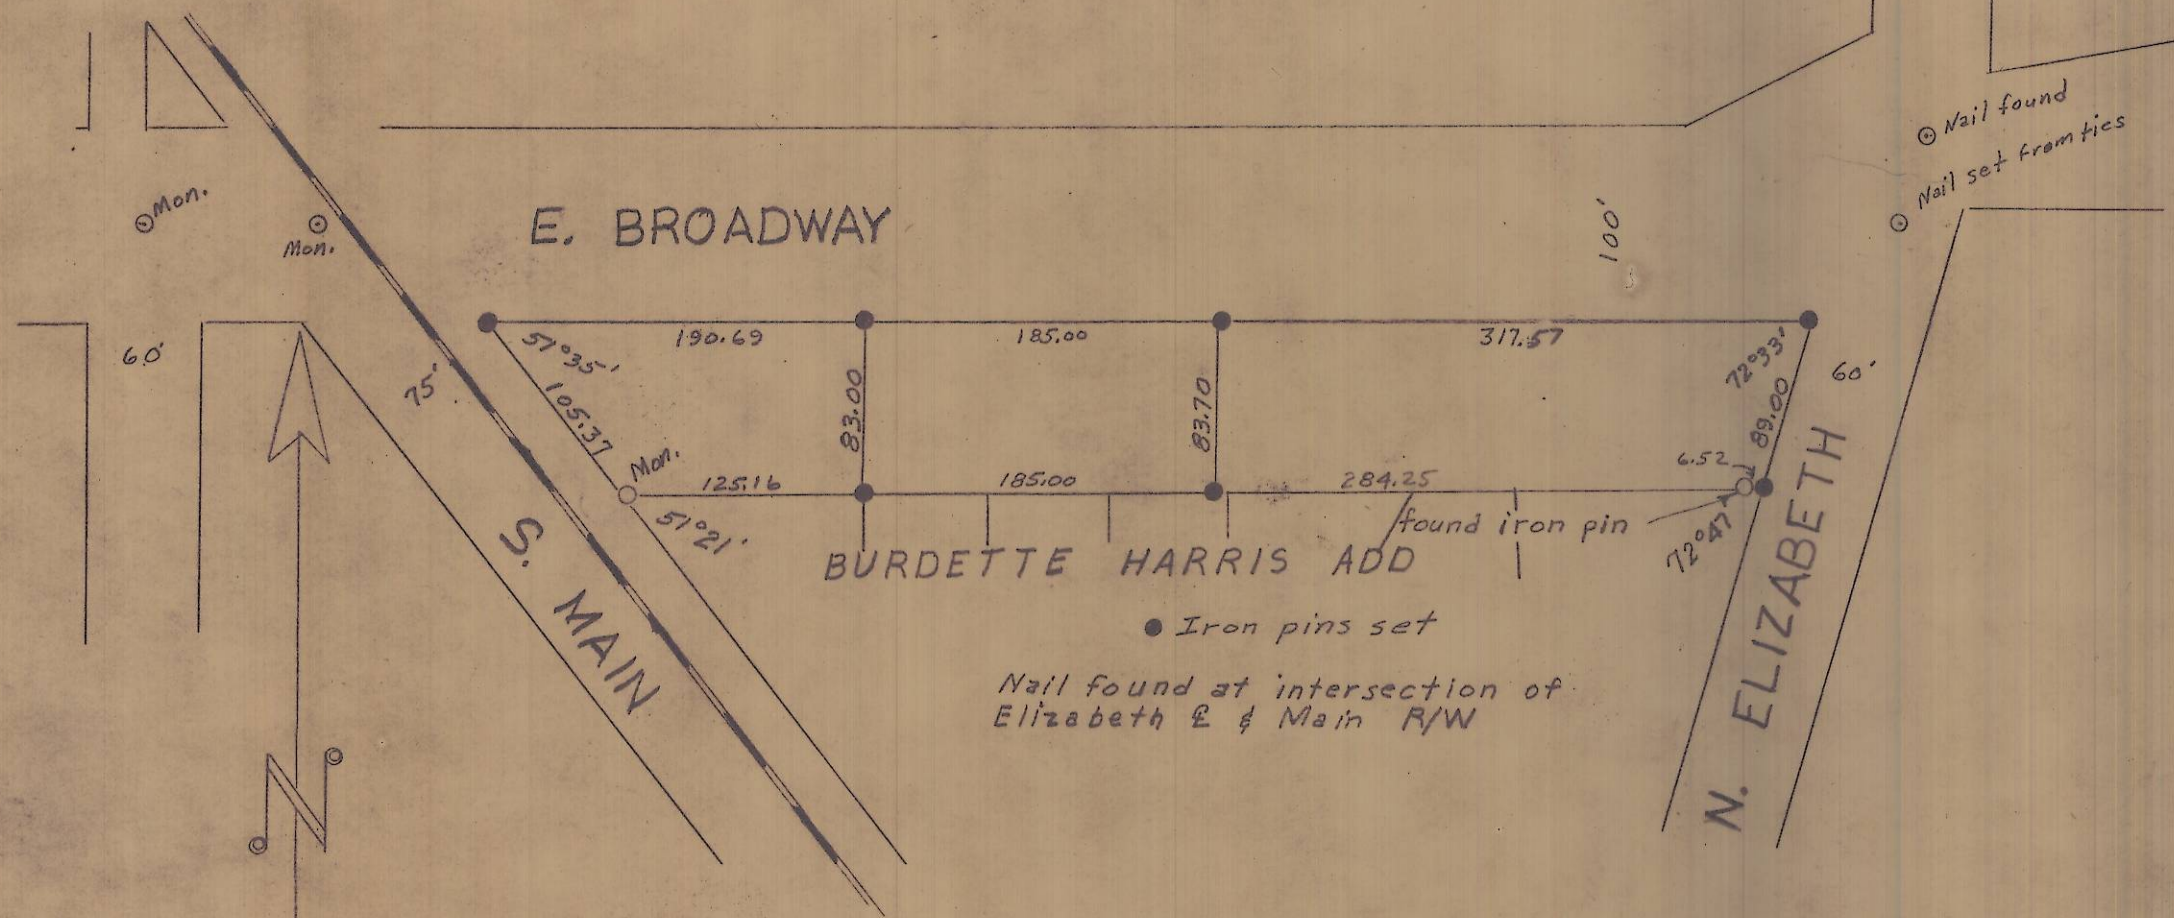

Survey for
CITY OF MILTON FREEWATER

Scale 1" = 100'

Aug. 21, 1972

Guy W. Streamer, Jr.
 Professional Engineer



Beattie's Survey
 SN-35-01CB

Survey 634
 H-136