


found Mon. at Elizabeth & Second

found several points on section line and highway

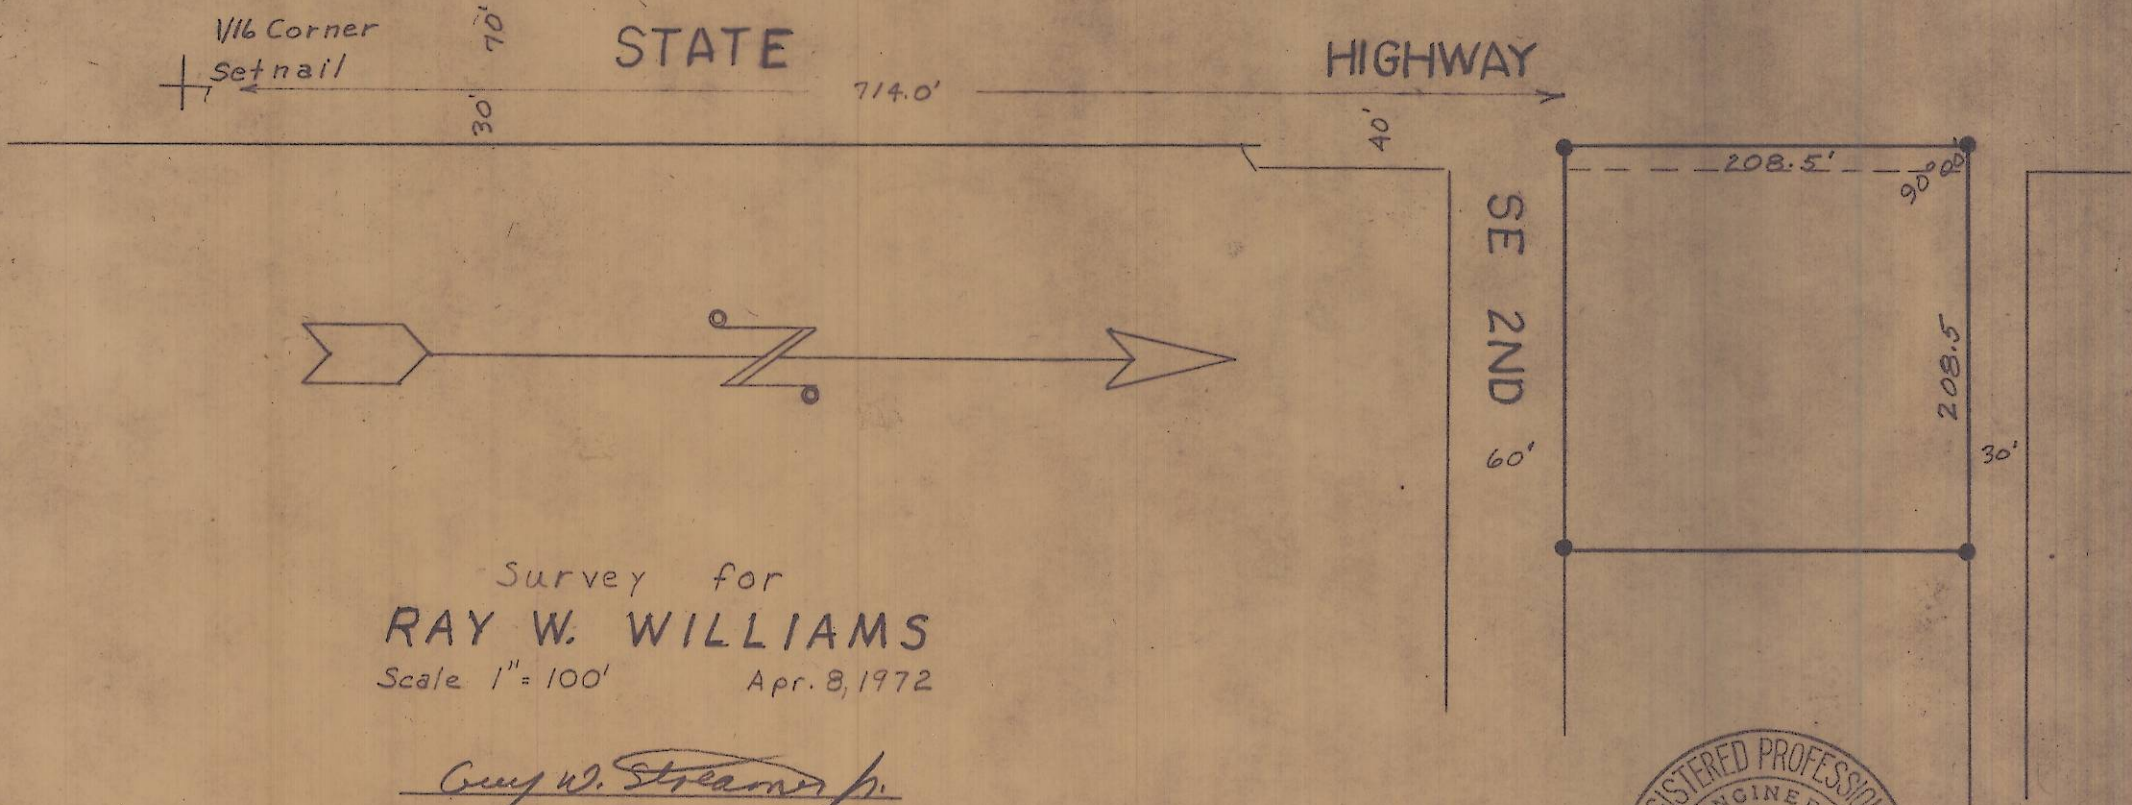

Survey for  
**RAY W. WILLIAMS**  
Scale 1" = 100' Apr. 8, 1972

*Guy W. Streamer, Jr.*  
Professional Engineer



H-138-AV  
5N-35-01CD

Survey 611  
H-138