

COUNTY RD. 565

S 89° 07' 46" E

322.63'

R=40

LOT 1

99.37

6'

BRIDLE DRIVE

109.15

R=40  
74.53

LOT 2

135.81

GALLOWAY LOOP

6'

198.67

STATE HWY 395

100'

N 21° 12' 19" W  
212.5


100'

N 19° 47' 52" W  
165.5

100'

S 73° 53' W  
347.19'

FND 1/2" IRON  
PIN

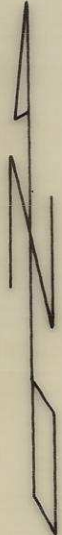

● DENOTE 3/8" PIN FND.

REGISTERED  
PROFESSIONAL  
LAND SURVEYOR

David N. Kumbien

DAVID N. KUMBIEN

WAYNE HARRIS CO., INC.

SURVEY FOR

GRIGGS - DICKEY

LOTS 1 & 2, BLOCK 2

COUNTRY-AIRE ESTATES

4-204-Ax

SCALE	DATE	DRNG BY	DRNG No
1"=100'	12-29-72	LL	72-350