


HWY & CURVE DATA

2°18' C.L.
 TA = 45° 56' 30"
 Ts = 1282.30'
 450' SPIRALS
 S = 5° 10' 30"
 LC = 449.84

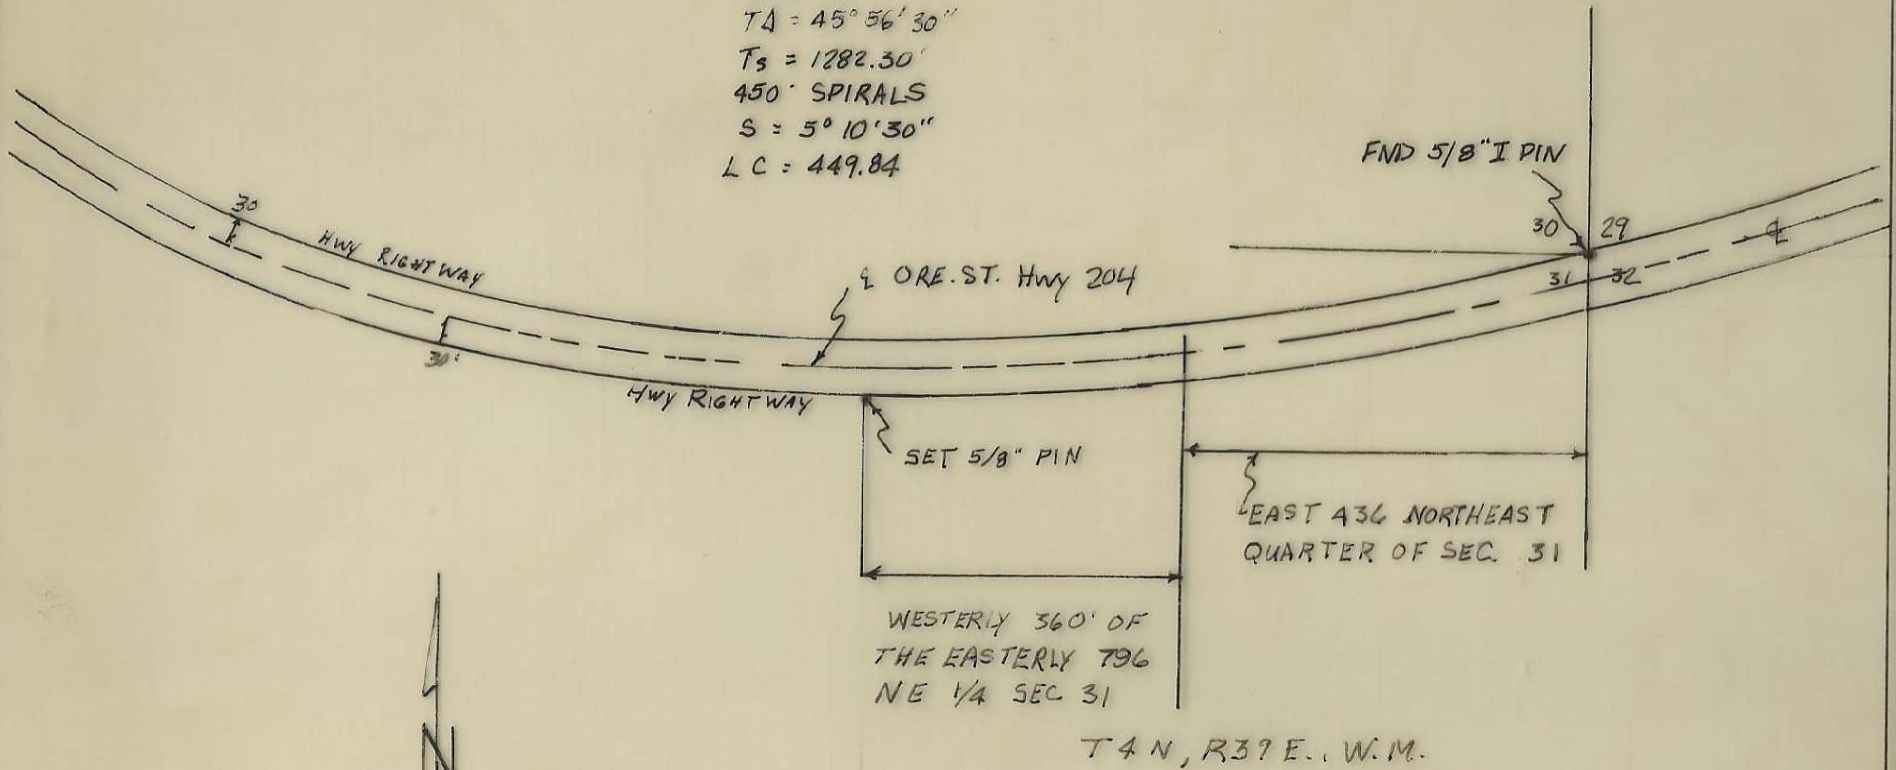

T4N, R37E., W.M.

WAYNE HARRIS CO., INC.

SURVEY FOR

MEADOWOOD SPEECH CAMP
 DESCRIPTIVE PARCEL IN
 NE 1/4 SEC. 31, T.4N., R.37E., W.M.

SCALE	DATE	DRN BY	DRNG NO.
1"=200'	5-7-73	TH	73-354

DAVID H. HARRIS
 DAVID H. HARRIS

11-207