


H-232-Ax

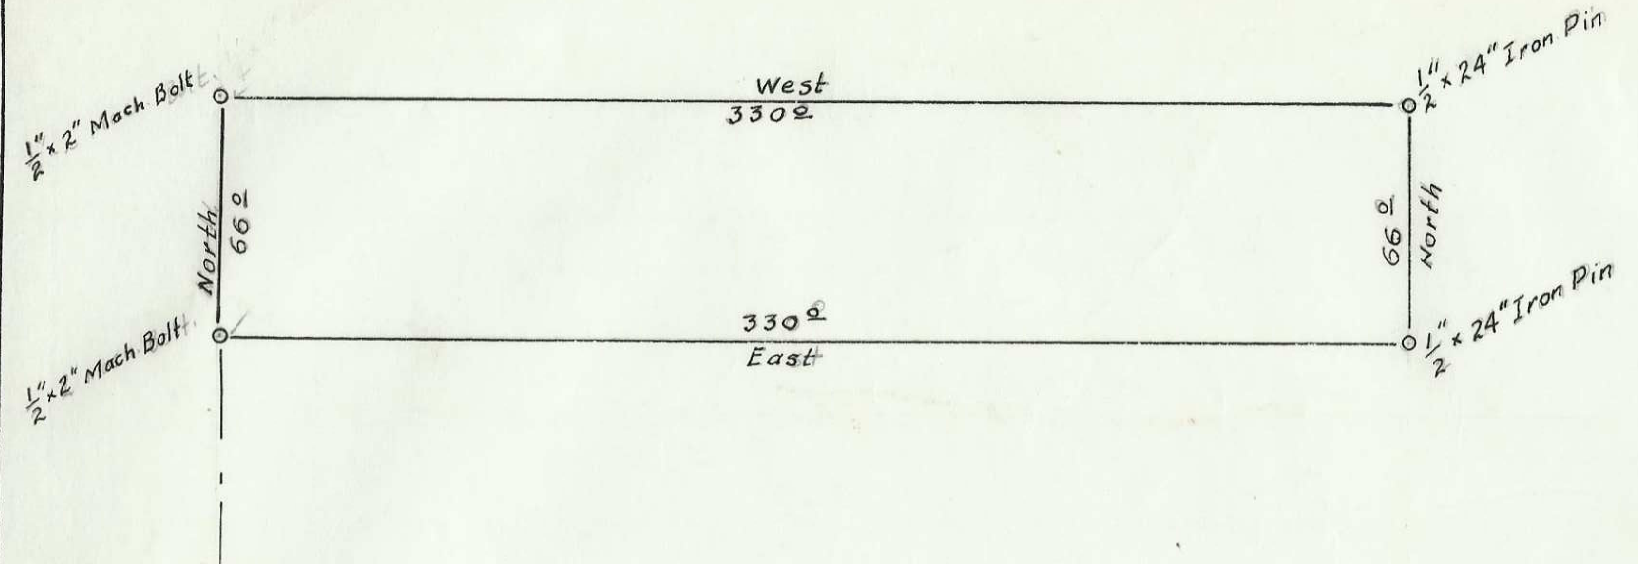


LEGEND ↗

POINTS FOUND AS NOTED ◻

POINTS SET AS NOTED ○

Bearings refer to property description directions calling west line of section 10 North.

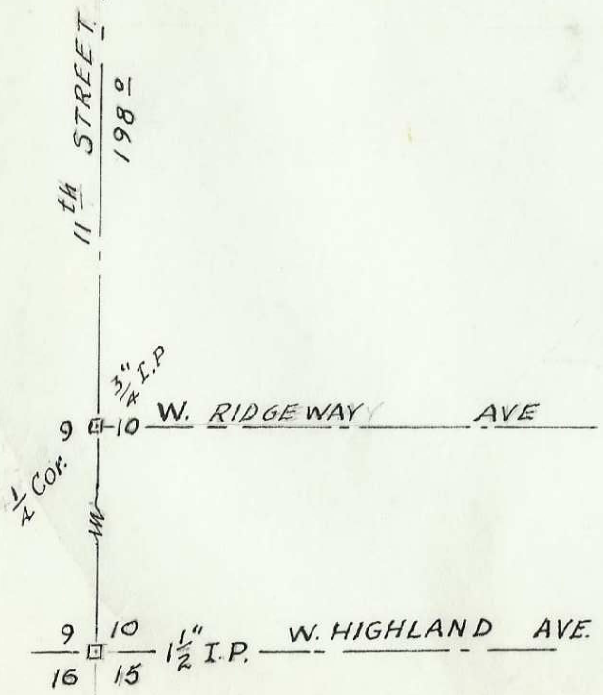

PLAT OF SURVEY OF LOT
 IN SW $\frac{1}{4}$ /NW $\frac{1}{4}$ SEC. 10, T4N, R28E, W.M.
 HERMISTON, OREGON
 FOR JAMES WATTS
 SCALE 1" = 50' 5/26/73