


H-234-Ax

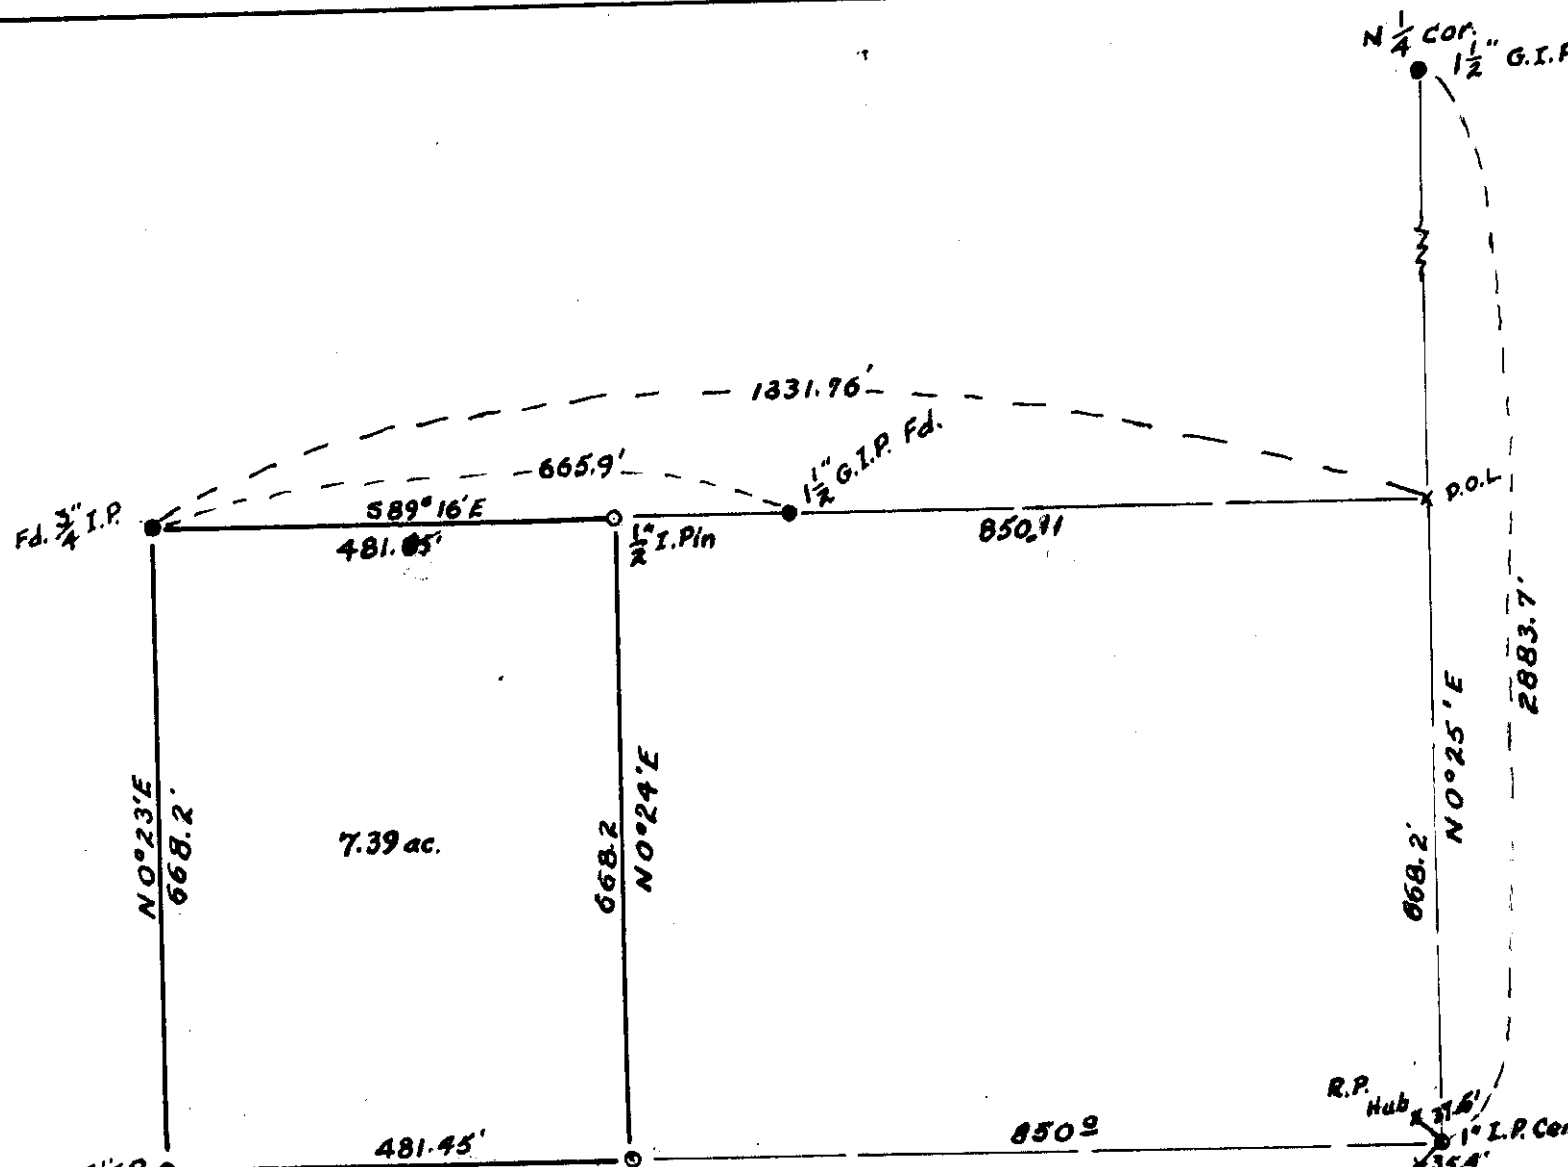

Points Found ● as noted  
 Points Set ○ as noted  
 Basis for bearings are  
 points and bearings used or  
 established by Verl Fraleys  
 surveys in this section on file  
 in County Surveyor's Office



PLAT OF PROPERTY SURVEY  
 IN SE 1/4 of N.W. 1/4 SEC. 1, T4N., R28E., W.M.  
 UMATILLA COUNTY OREGON  
 FOR RON WHITE & WAYNE THOMPSON

SCALE 1" = 200'      DATE 5/1/73

H-234