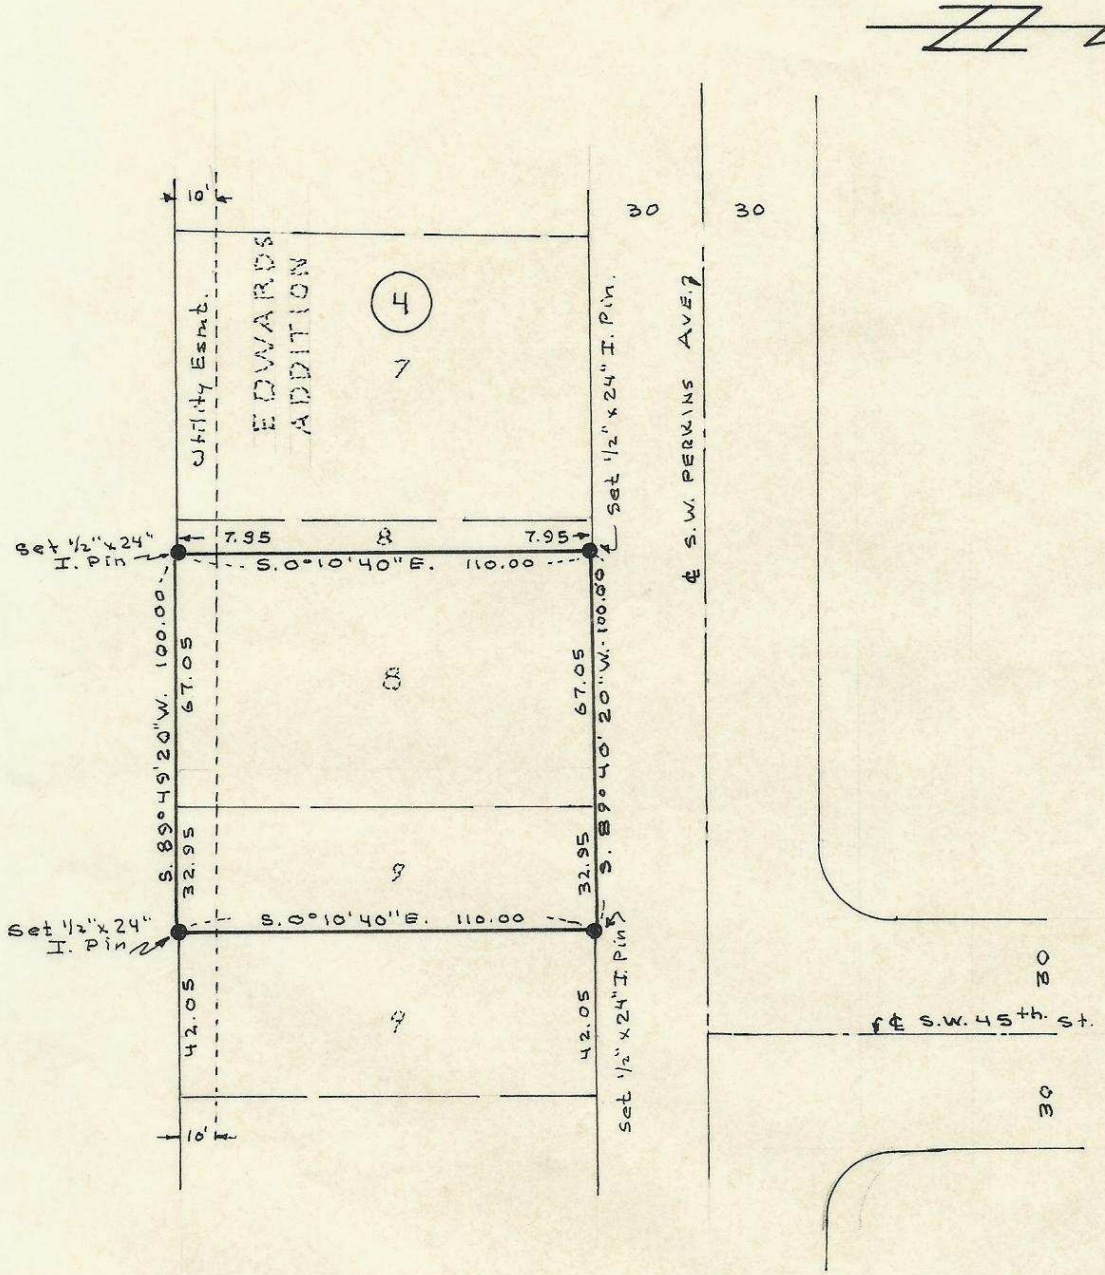

I-53

LOT SURVEY FOR
SHERWOOD & ROBERTS
IN EDWARDS ADDITION
PENDLETON, OREGON

DRN: HFS	DATE: 4-25-74	SCALE: 1" = 50'

DONALD L. STAEBLER
CONSULTING ENGINEER
P.O. BOX 91
PENDLETON OREGON 97801

REGISTERED PROFESSIONAL ENGINEER 5408 OREGON JULY 9, 1965 DONALD L. STAEBLER

Donald L. Staebler

I-53-Ax