


T-94-Ax

OLD FREEWATER
60'
HIGHWAY

Found R.R. spike
Center Section

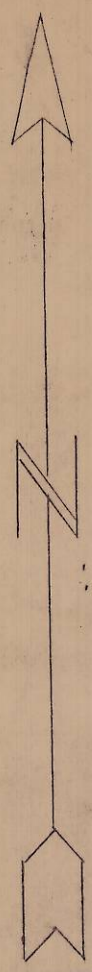

89°34'
set 1/2" I. pin

300.79

set 1/2" I. pin

46.55

285.0

89°34'

640.0

Feed Lot tract

400.0

Fertilizer tract

400.0

W. W. Y. R. R.

30'

set 1/2" I. pin

129.0

11.55
Church tract

132.0

285.0
320.0

30'

set 1/2" I. pin

89°34'

240.0

52.0
25.0
51.0

found 3/4" I. pin

89°34'
found 1/2" I. pin

442.79


COBB ROAD

203.0

Found nail
at 1/16 cor

SURVEY FOR
LYLE BROWN

SEC. 35 T. 6 N., R. 35 E. W. M.
Scale 1" = 100' Dec. 3, 1972

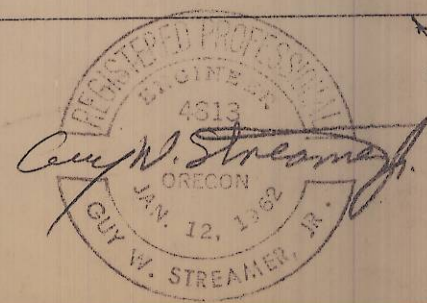

89°34'

I-94

Survey 651