


PLAT OF SURVEY  
OF


Lots 11 & 12, Block 10, Original Town of  
Freewater, Now City of Milton-Freewater;  
Umatilla County, Oregon.

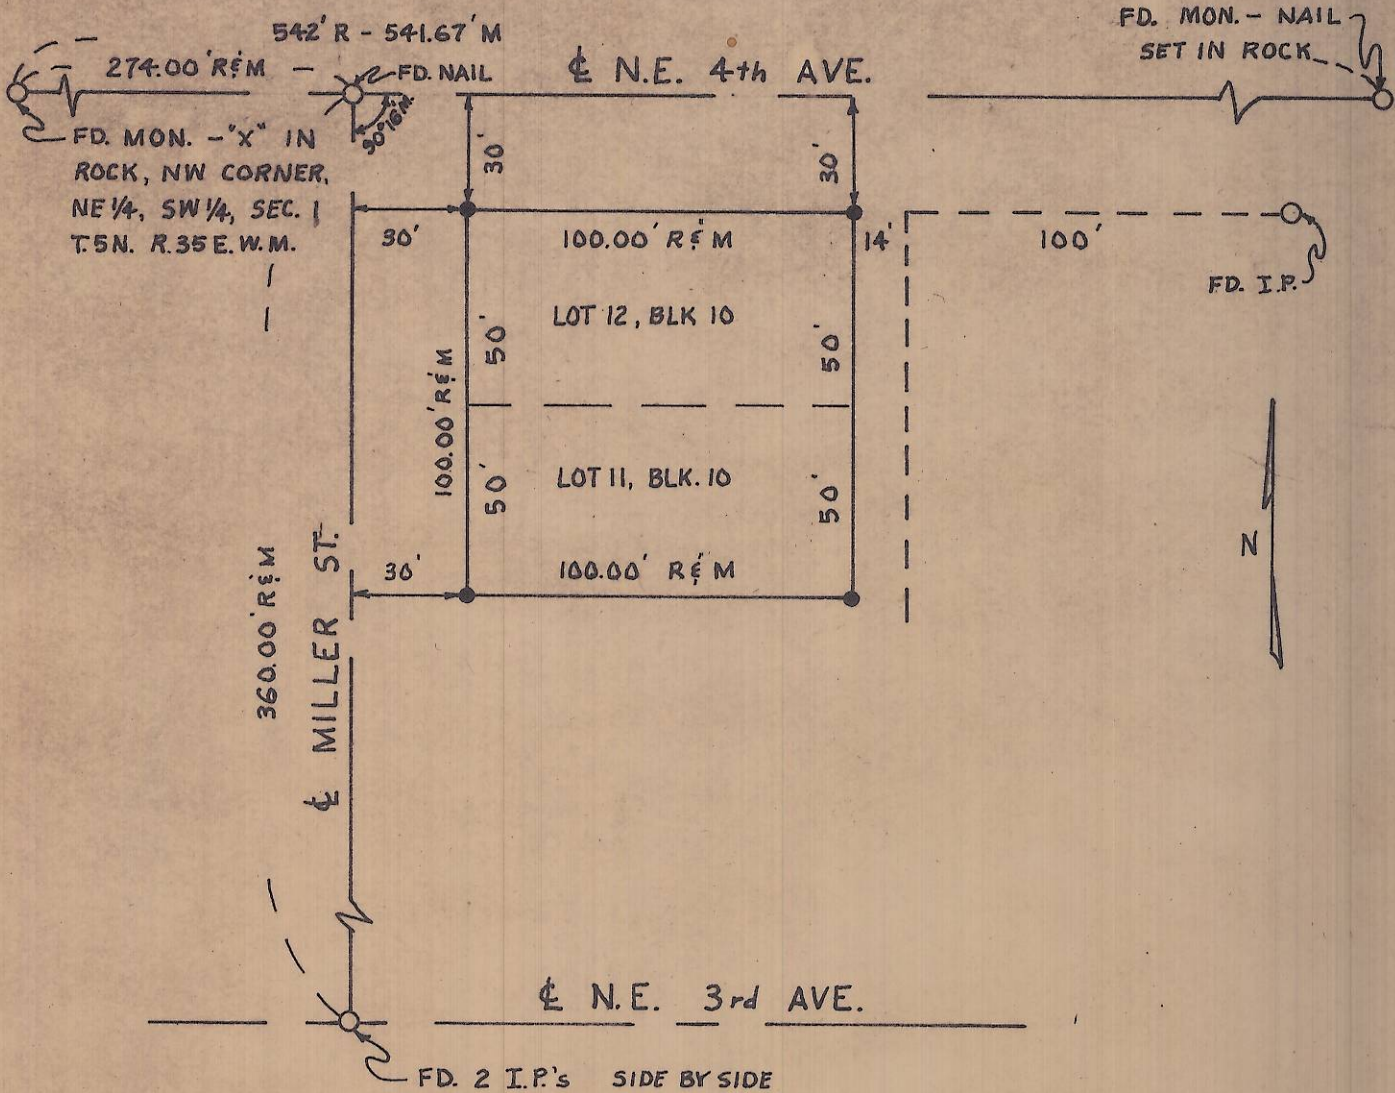

I, Jim D. Dwyer, Registered  
Professional Engineer, hereby certify  
that I have surveyed the property described  
hereon and the plat hereon drawn is a  
correct representation of same.

- = IRON PIN SET
- R = RECORD DISTANCE
- M = MEASURED DISTANCE

J-4  
~~75-4~~

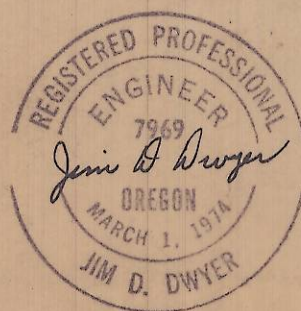

PROPERTY SURVEY FOR  
RON JONES  
Milton Freewater, Oregon  
BY  
JIM D. DWYER  
Registered Professional Engineer  
Date: 1-12-75      Scale: 1" = 50'

J-4-Ax