


PLAT OF SURVEY
OF

LOTS 4, 5, & 6, BLOCK 10, ORIGINAL TOWN OF
FREEWATER, NOW CITY OF MILTON-FREEWATER;
UMATILLA COUNTY, OREGON

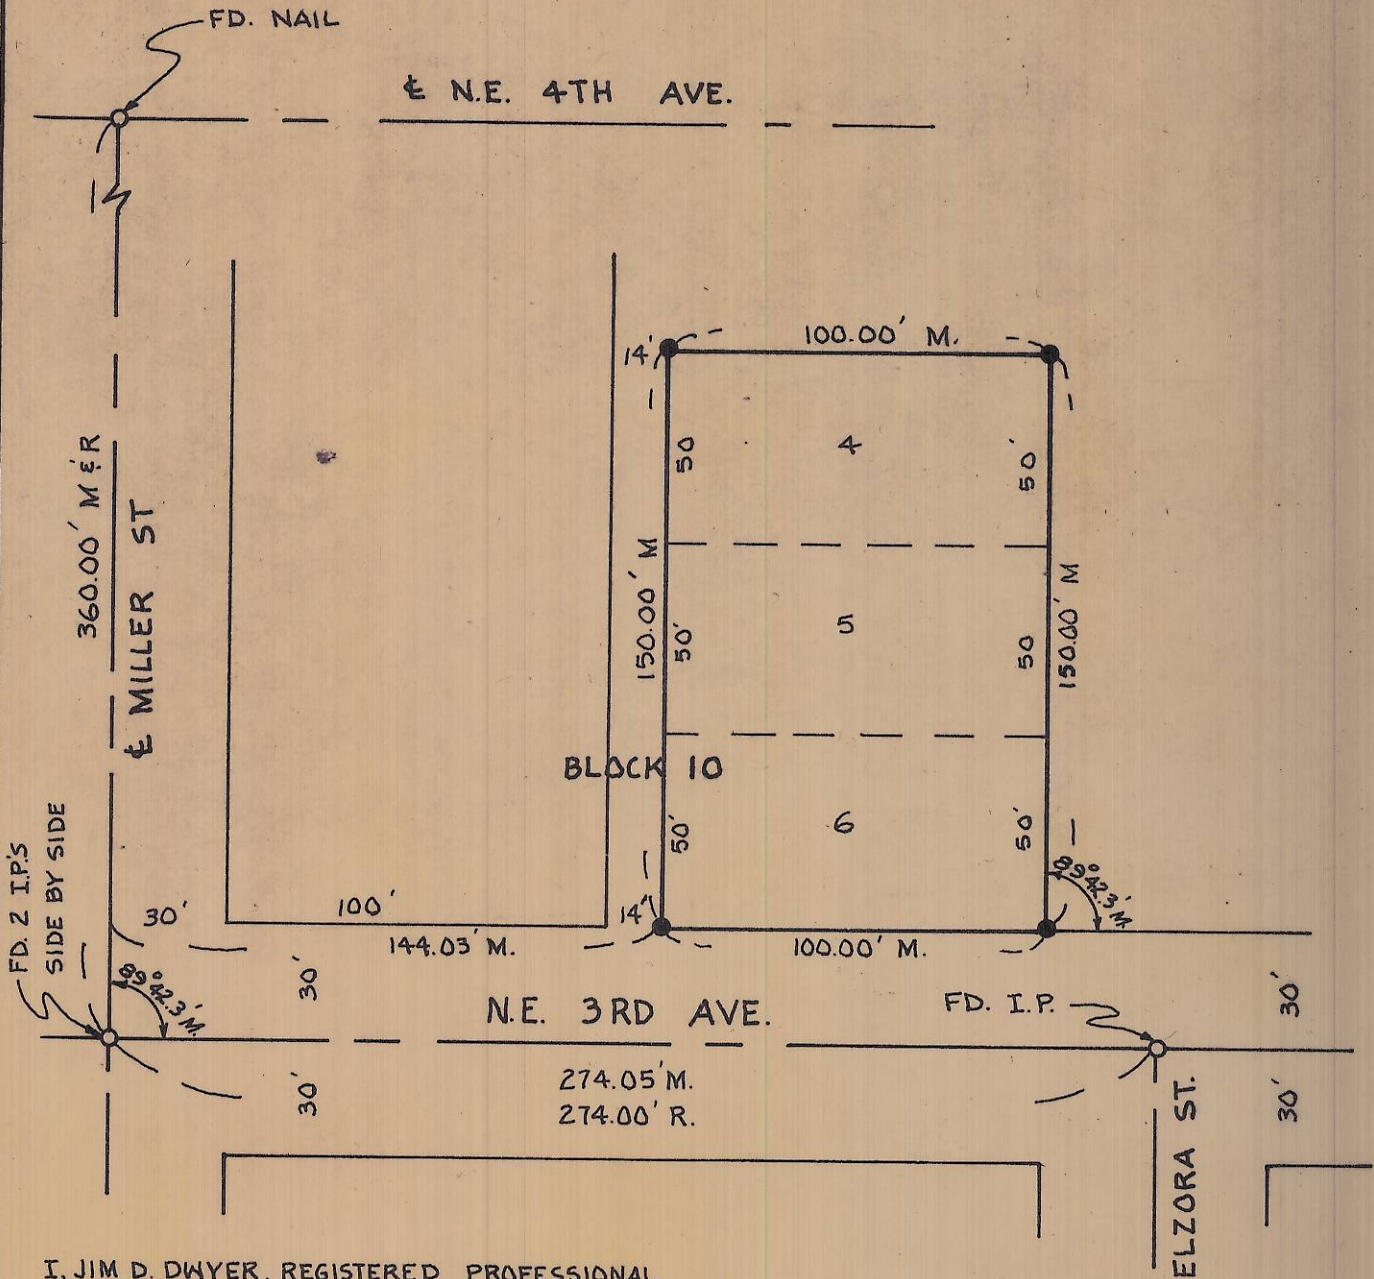

I, JIM D. DWYER, REGISTERED PROFESSIONAL
ENGINEER, HEREBY CERTIFY THAT I HAVE
SURVEYED THE PROPERTY DESCRIBED
HEREON AND THE PLAT HEREON DRAWN
IS A CORRECT REPRESENTATION OF
SAME.

- = SET 5/8" IRON PIN
- R = RECORD
- M = MEASURED



SURVEY FOR C.W. TAYLOR
913 N.E. 3RD AVE.
MILTON FREEWATER, OREGON
BY:
JIM D. DWYER
PROFESSIONAL ENGINEER
10 N. MADISON ST., WALLA WALLA, WASH.
DATE: 4-22-75 SCALE: 1" = 50'

J-17-Ax