


J-143-Ax



LEGEND ✓  
 □ Points found as noted  
 ○ Points set as noted  
 Bearings related to true bearing  
 of W. Line of Sec. 15 being 50°40'50"E

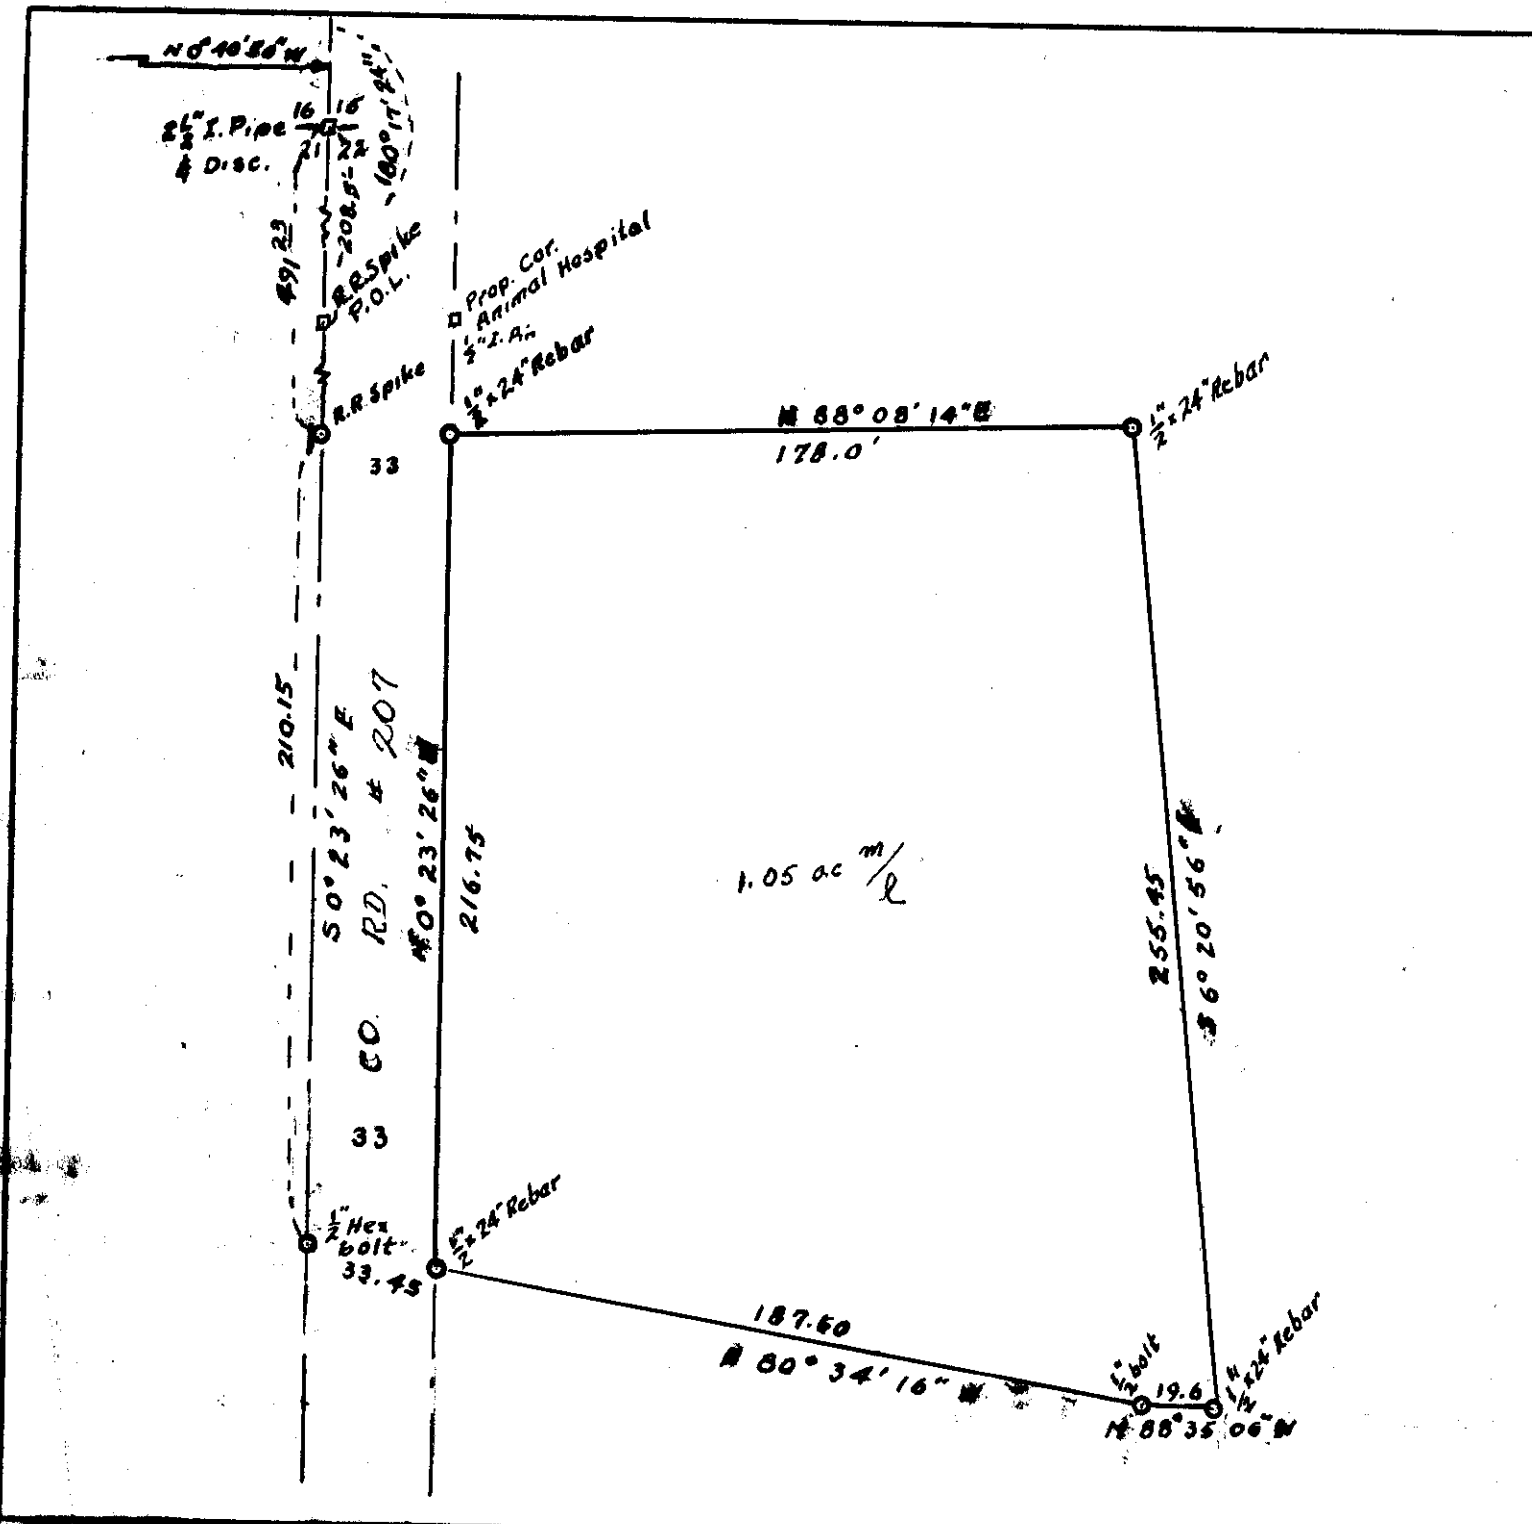

PLAT OF SURVEY OF TRACT  
 IN NW 1/4 SEC. 22, T 4N, R 28E, W.M.  
 FOR ZONA HARDER  
 Scale 1" = 50'

7/5/75  
 J-143