



K-48

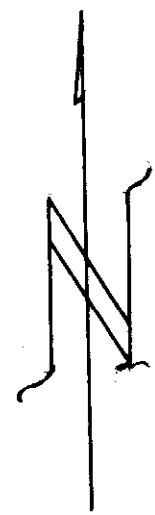

LEGEND:
 □ POINTS FOUND AS NOTED
 ○ POINTS SET 1/2" x 24" REBARS
 BEARINGS ADOPTED FROM
 SURVEY OF ADJACENT TRACTS.
 BY OTHERS. ON FILE

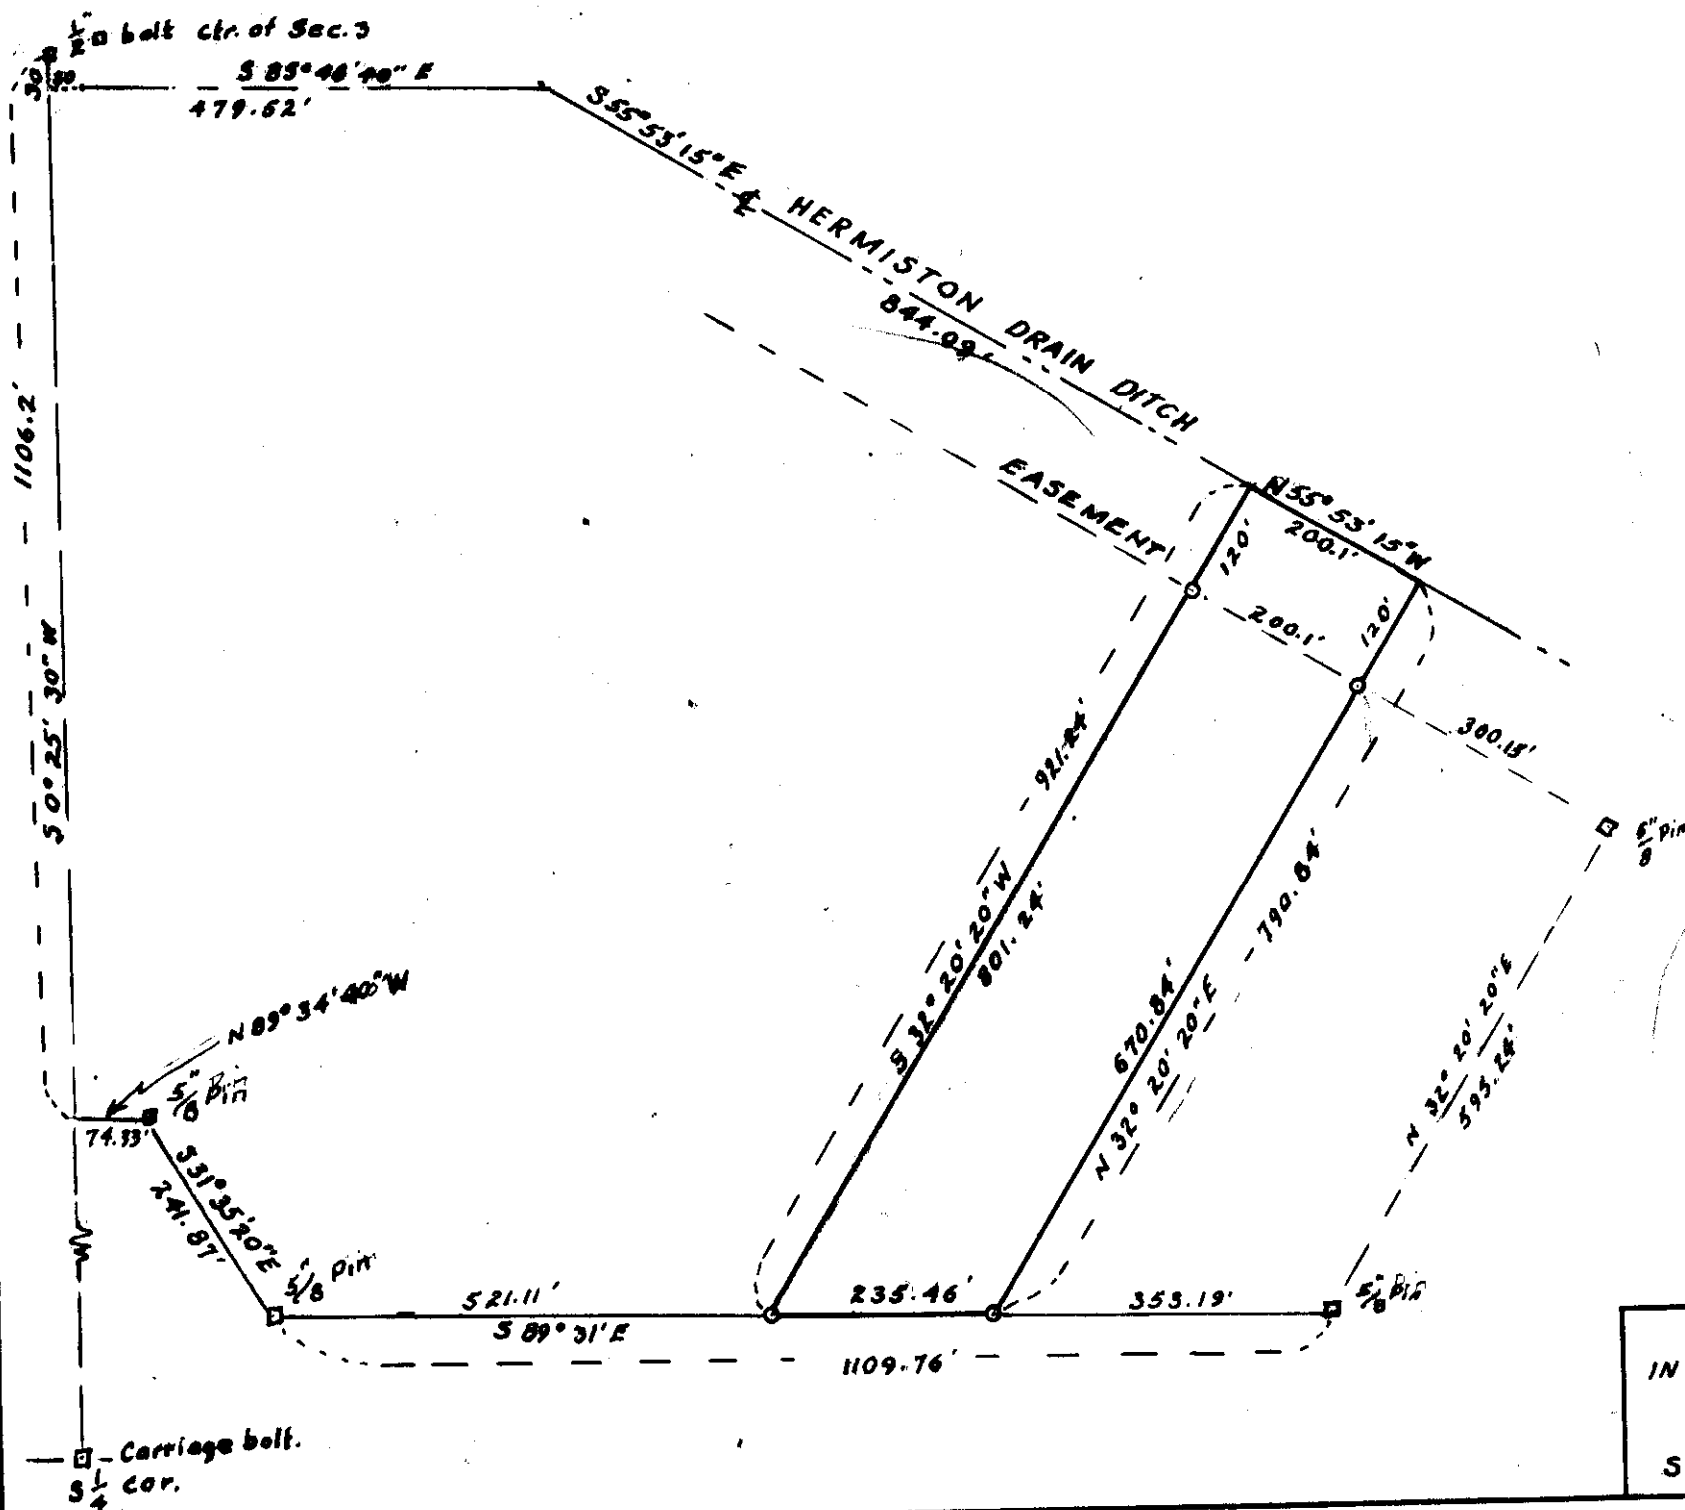

PLAT OF TRACT SURVEY
 IN NE 1/4 / SE 1/4 SEC. 3, T4N, R28E, W.M.
 UMATILLA CO
 FOR DON SHOCKMAN
 SCALE 1" = 300' 2-26-76

□ - Carriage bolt.
 S 1/4 cor.

K-48