


M-82

M-82-AX

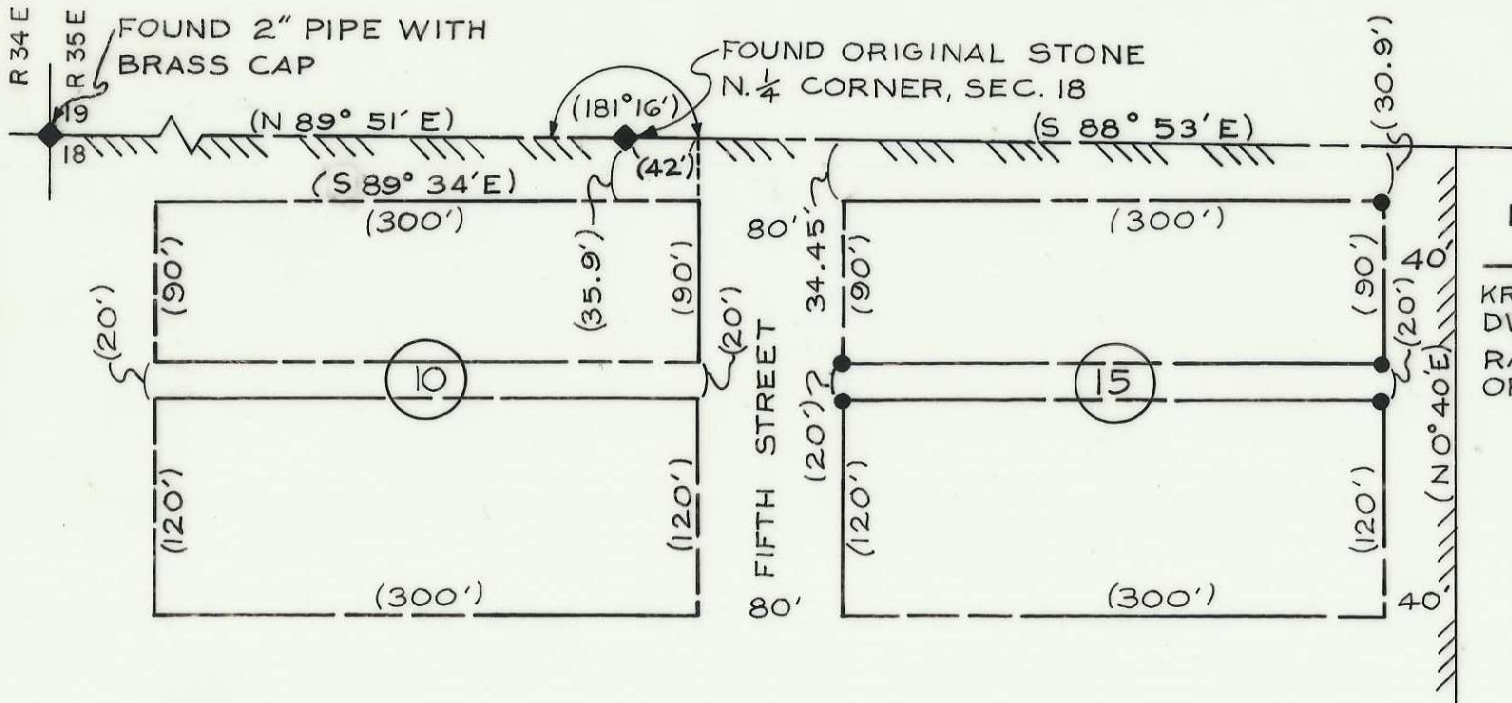

REFERENCE MATERIAL
 KRUMBEIN ENG. CO.
 DWG. NO. 76-16B
 RAILROAD ADD.
 ORIGINAL PLAT



LEGEND

- ◆ FOUND MONUMENT OF RECORD
- SET 5/8" x 30" STEEL PIN WITH CAP MARKED A.P.&A
- SECTION LINE
- /// SUBDIVISION LINE
- 10 BLOCK NUMBER

BASIS OF BEARING

ORIGINAL SUBDIVISION PLAT



SURVEY OF CITY ALLEY BLOCK 15. RAILROAD ADDITION TO CITY OF ATHENA		
FOR: CITY OF ATHENA		
SCALE: 1" = 100'	anderson perry & associates, inc. <small>engineering • surveying • materials testing</small> LA GRANDE & ENTERPRISE, OREGON	SHEET NO.
DATE: JULY, 1977		

STANPAT PRODUCTS INC. PORT WASHINGTON, N.Y.

J/# 732

FILED HERE RECORDED 373