


Paul Graf

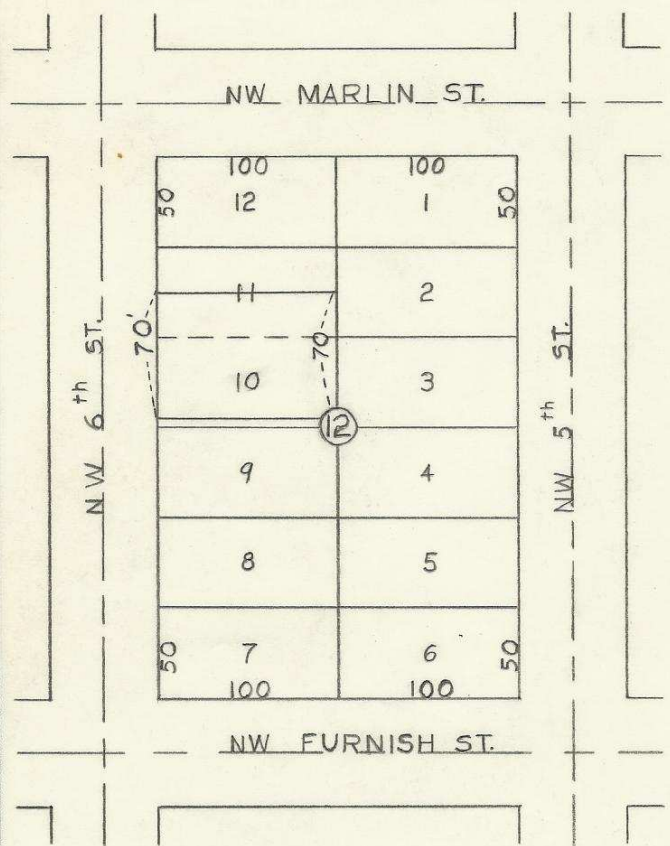

Q-129-Ax

HAYES & HARRIS ENGINEERING

SURVEY FOR
PAUL GRAF

N. 45', LOT 10 & S. 1/2, LOT 11, BLK. 12,
LIVERMORE ADD'N PENDLETON, ORE.

T2N 32 03DC

SCALE	DATE	DRAWN BY
1"=100'	3-22-55	W. O. H.

50' x 100'