


Plat of Lot 4 Block 8 of Curry's Addition to City of Pendleton, Ore.
 Scale: 1 inch = 20 Feet.
 Surveyed, Staked, Gridded on 15 Ft. Grids, and platted, By W.E.O. Criger.
 B.M. Elev. Assumed; Intersection on Pav't.
 For George Woodward - Feb-20-1948.

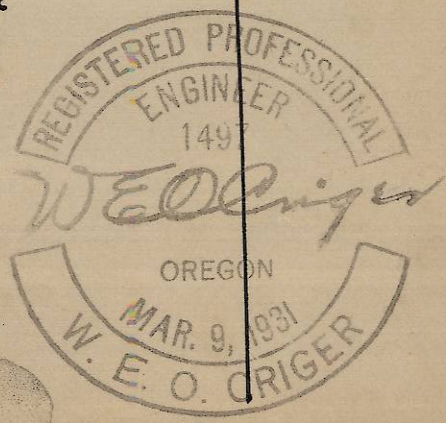

Q-0143-AX

④