


Q-156-AX

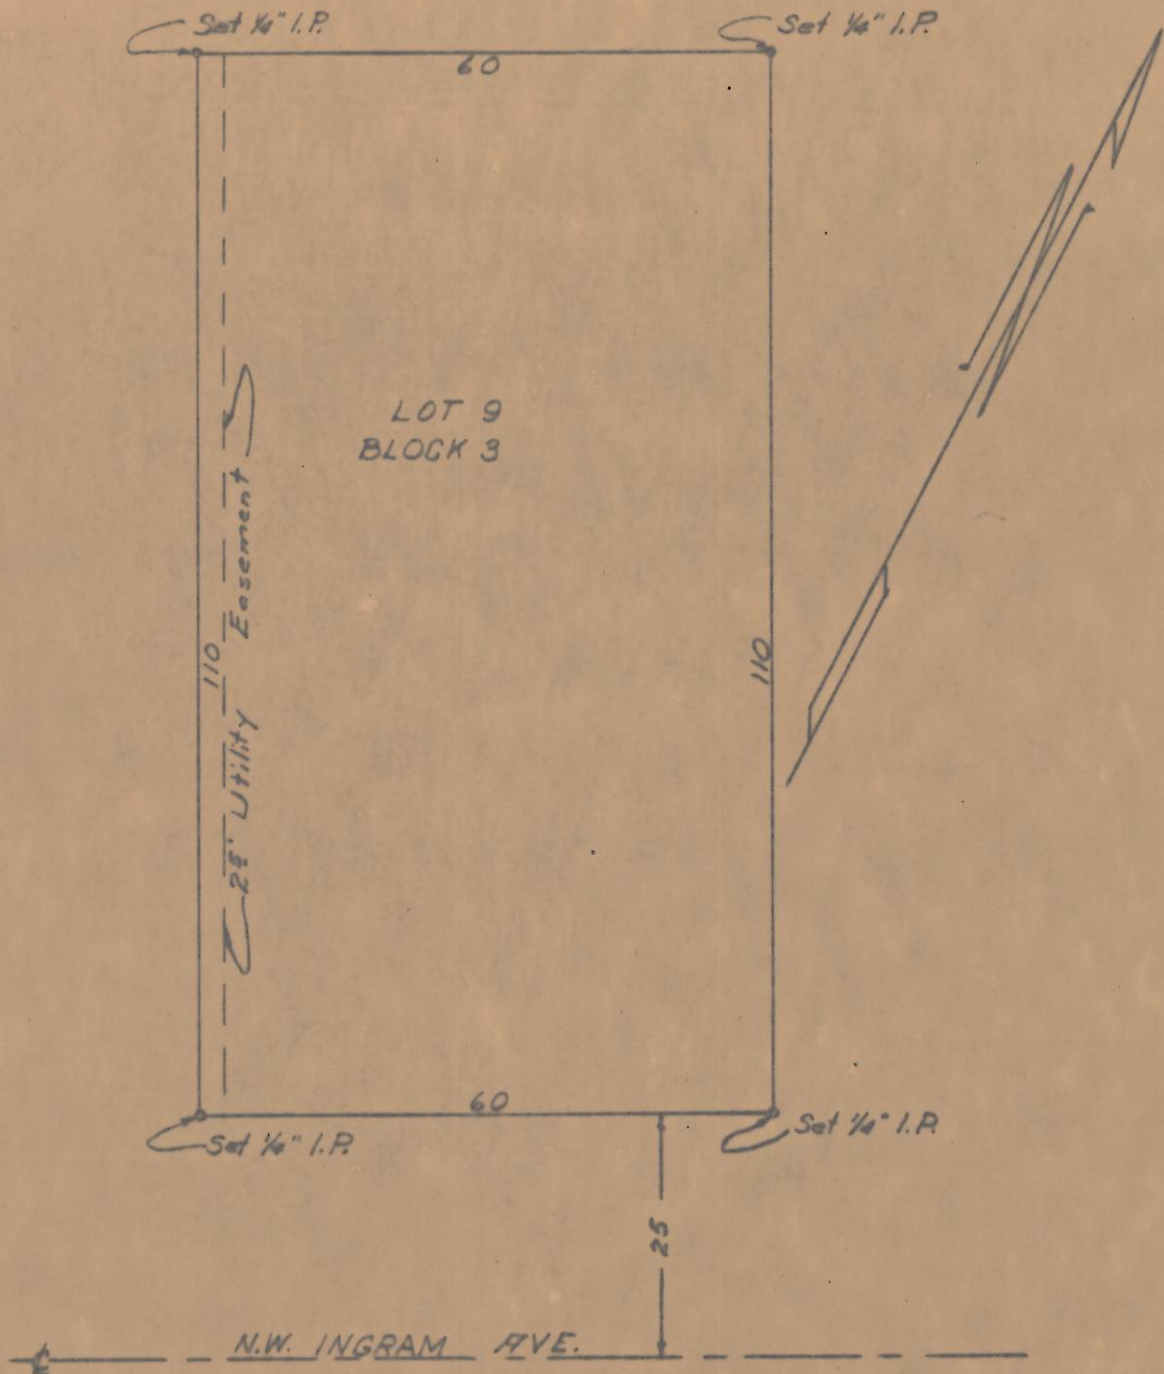

← N.W. INGRAM AVE. →

NE⁴ SW⁴ 3

REGISTERED
OREGON
LAND SURVEYOR

Wayne O Harris

MAY 9, 1955
WAYNE O. HARRIS
346

HAYES AND HARRIS			
SURVEY FOR			
LESTER MOENS			
LOT 9		BLOCK 3	
WEST HILLS ADDITION			
PENDLETON, OREGON			423
Scale	Date	Drg. By	Drg. No.
1"=20'	12/10/57	aby	

ORIG

Q-156-AX