


Q-169-AX

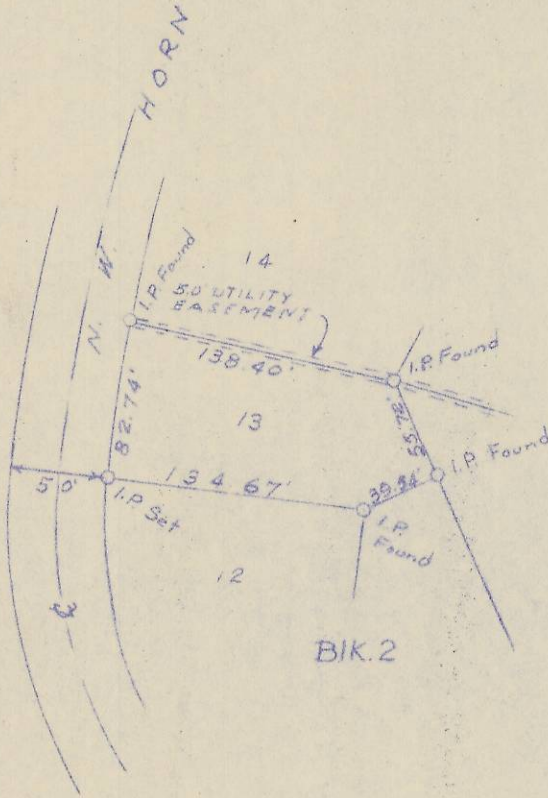

2032 3CA NW⁴ SW⁴ ③

REGISTERED
OREGON
LAND SURVEYOR
Wayne O. Harris
MAY 8, 1955
WAYNE O. HARRIS
346

HAYES & HARRIS ENGINEERING	
Survey For	
PENDLETON HOUSING CORPORATION	
LOT 13, BLOCK 2	
WEST HILLS ADDITION	
PENDLETON, OREGON	
SCALE	DATE
1" = 100'	1-8-57

231

Q-169-AX