


LEGEND

- 1/2"x24" IRON PINS
- IMPOSSIBLE TO SET PINS



Q-190-Ax

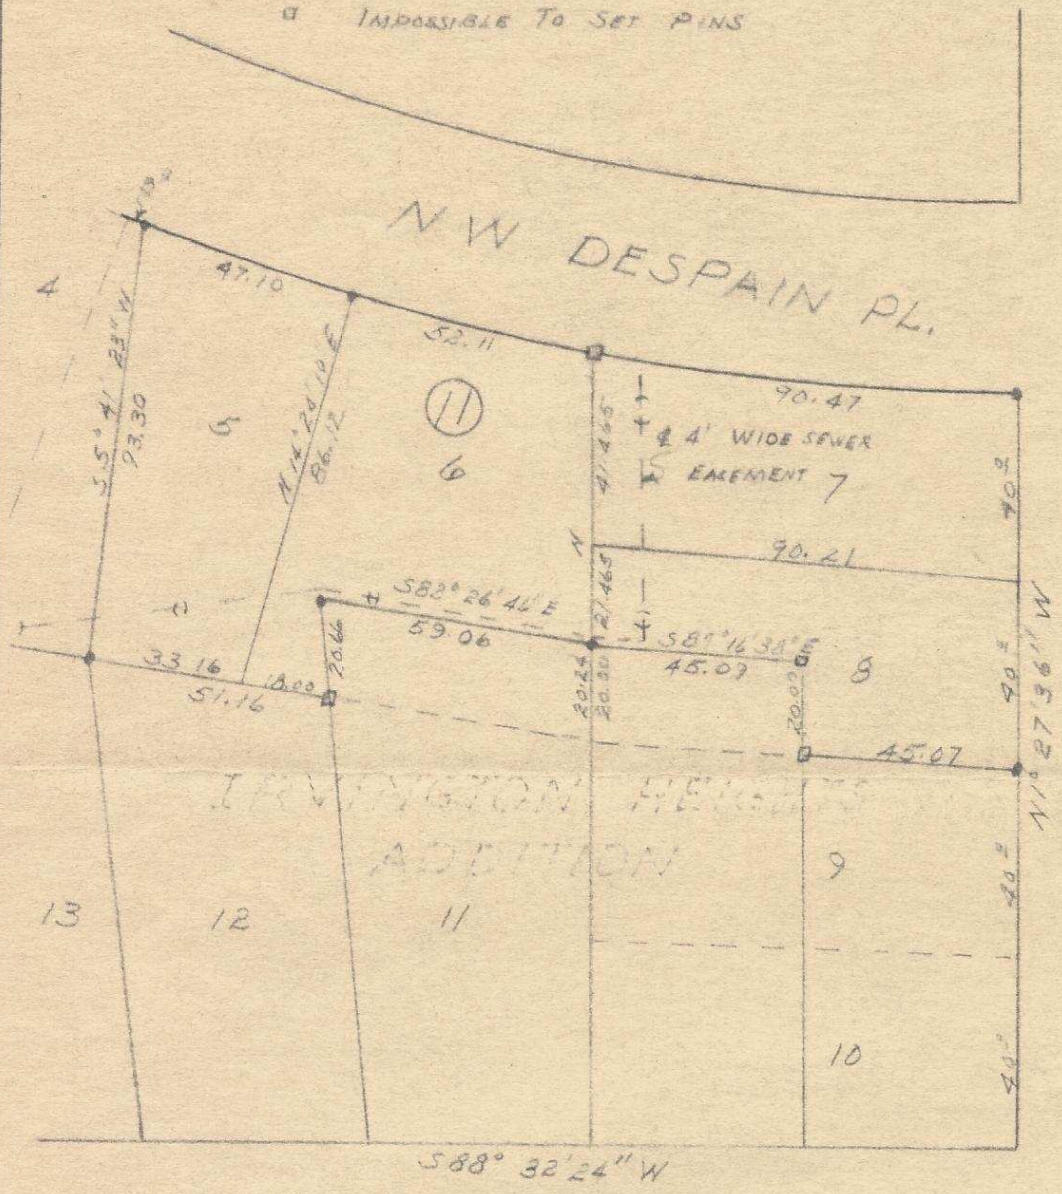

N W. DESPAIN



SE 4 SW 4 (3)

SCALE: 1" = 40' DATE: 6-12-56

WALL AND TENNESON
Engineers

The Dalles Oregon

Q-190-Ax

20