


Q-192-Ax

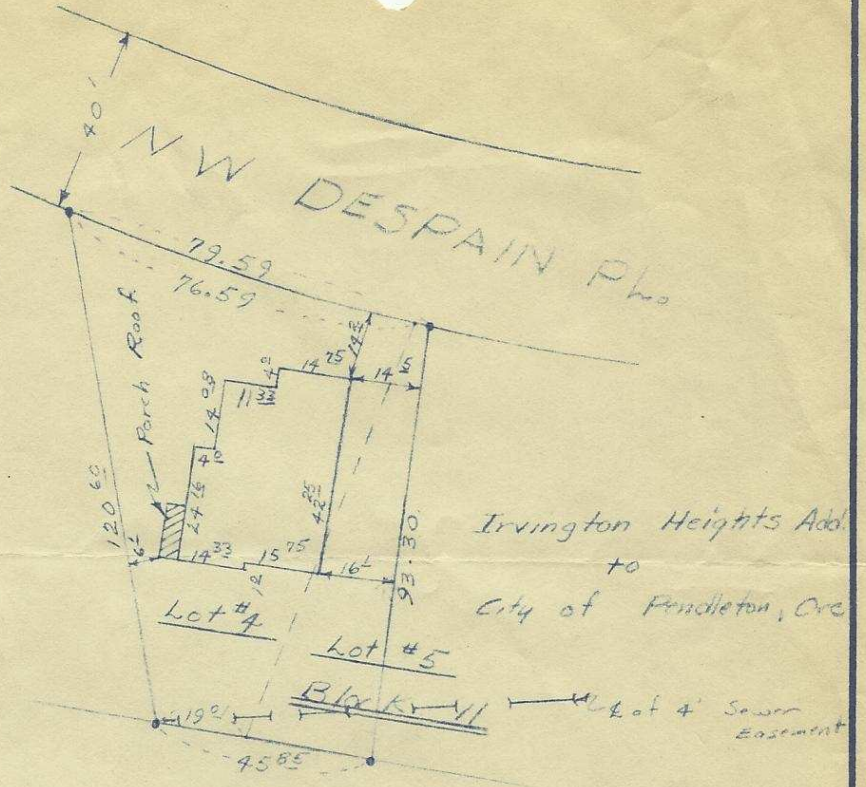

Note: The Northerly 20' of Lots 4 & 5 have an easement for Telephone, Telegraph and electrical transmission & distribution & their related appurtenances.

Plot Plan for

Mr & Mrs William T. Clark



SE 45W 4 (3)

SCALE: 1" = 40'	DATE: 3-27-57
WALL AND TENNESON	
Engineers 235	
The Dalles	Oregon

Q-192-Ax